


T.13S. R.1E.W.M.

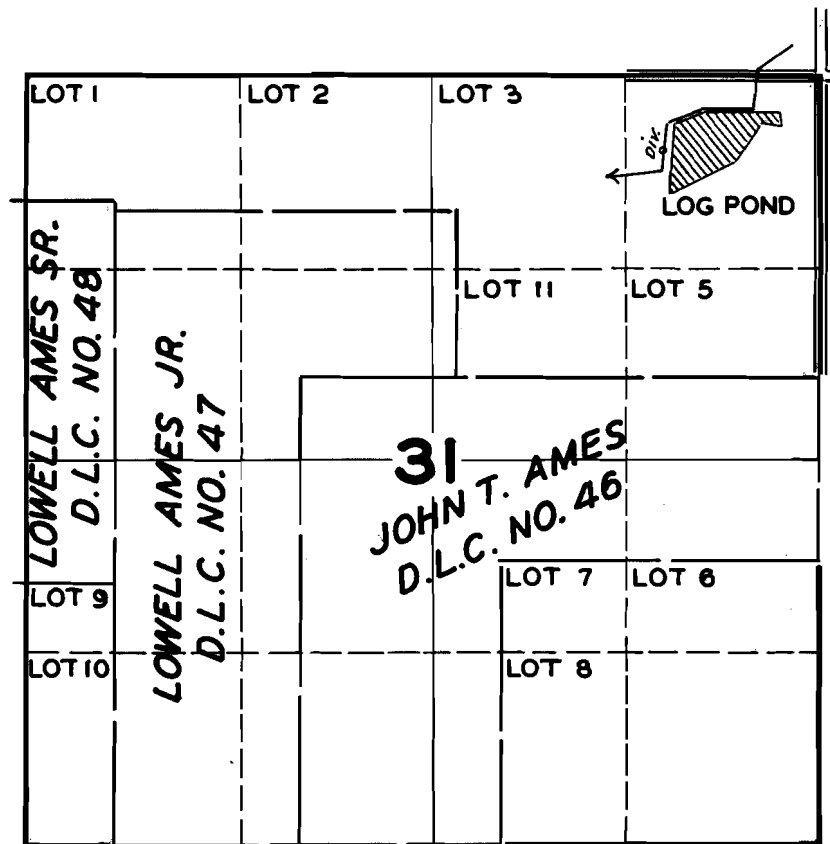

FINAL PROOF SURVEY

UNDER

R-23277

R-944

Application No. ~~23294~~ Permit No. ~~18377~~

IN NAME OF

WEST GATE LUMBER COMPANY

Surveyed MAR. 29 1949, by JAS. E. BUNNELL



Map Showing
Plan of Proposed Log Pond
Situated in Sect's 31 & 32 T.13 S. R.1 E. W.1 M.
Linn County Oregon
Scale 1"= 100' September 28, 1942