


*Survey*  
P-3226  
P-3227

# T.3S.R.13E.W.M.

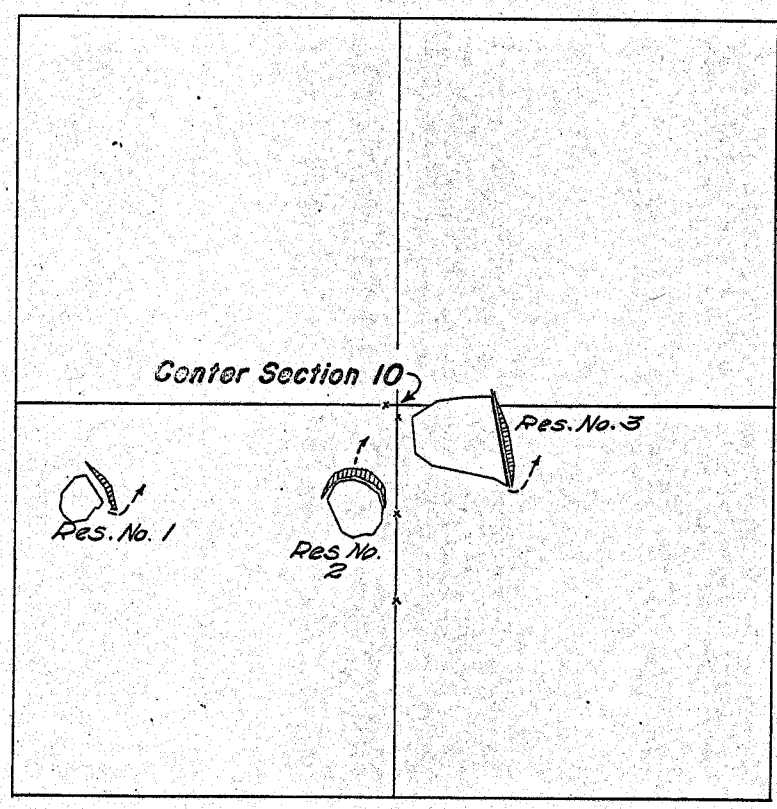

Scale : 1" = 660'

## FINAL PROOF SURVEY UNDER

Application No. ~~R-38465~~ ~~R-38466~~ Permit No. ~~R-3226~~ ~~R-3227~~  
IN NAME OF

WILBUR HENDRICKS

Surveyed Oct. 30, 1963, by *[Signature]*