


RECEIVED  
OCT 12 1972  
STATE ENGINEER  
SALEM, OREGON

RECEIVED  
STATE ENGINEER  
SALEM, OREGON

RECEIVED  
STATE ENGINEER  
SALEM, OREGON

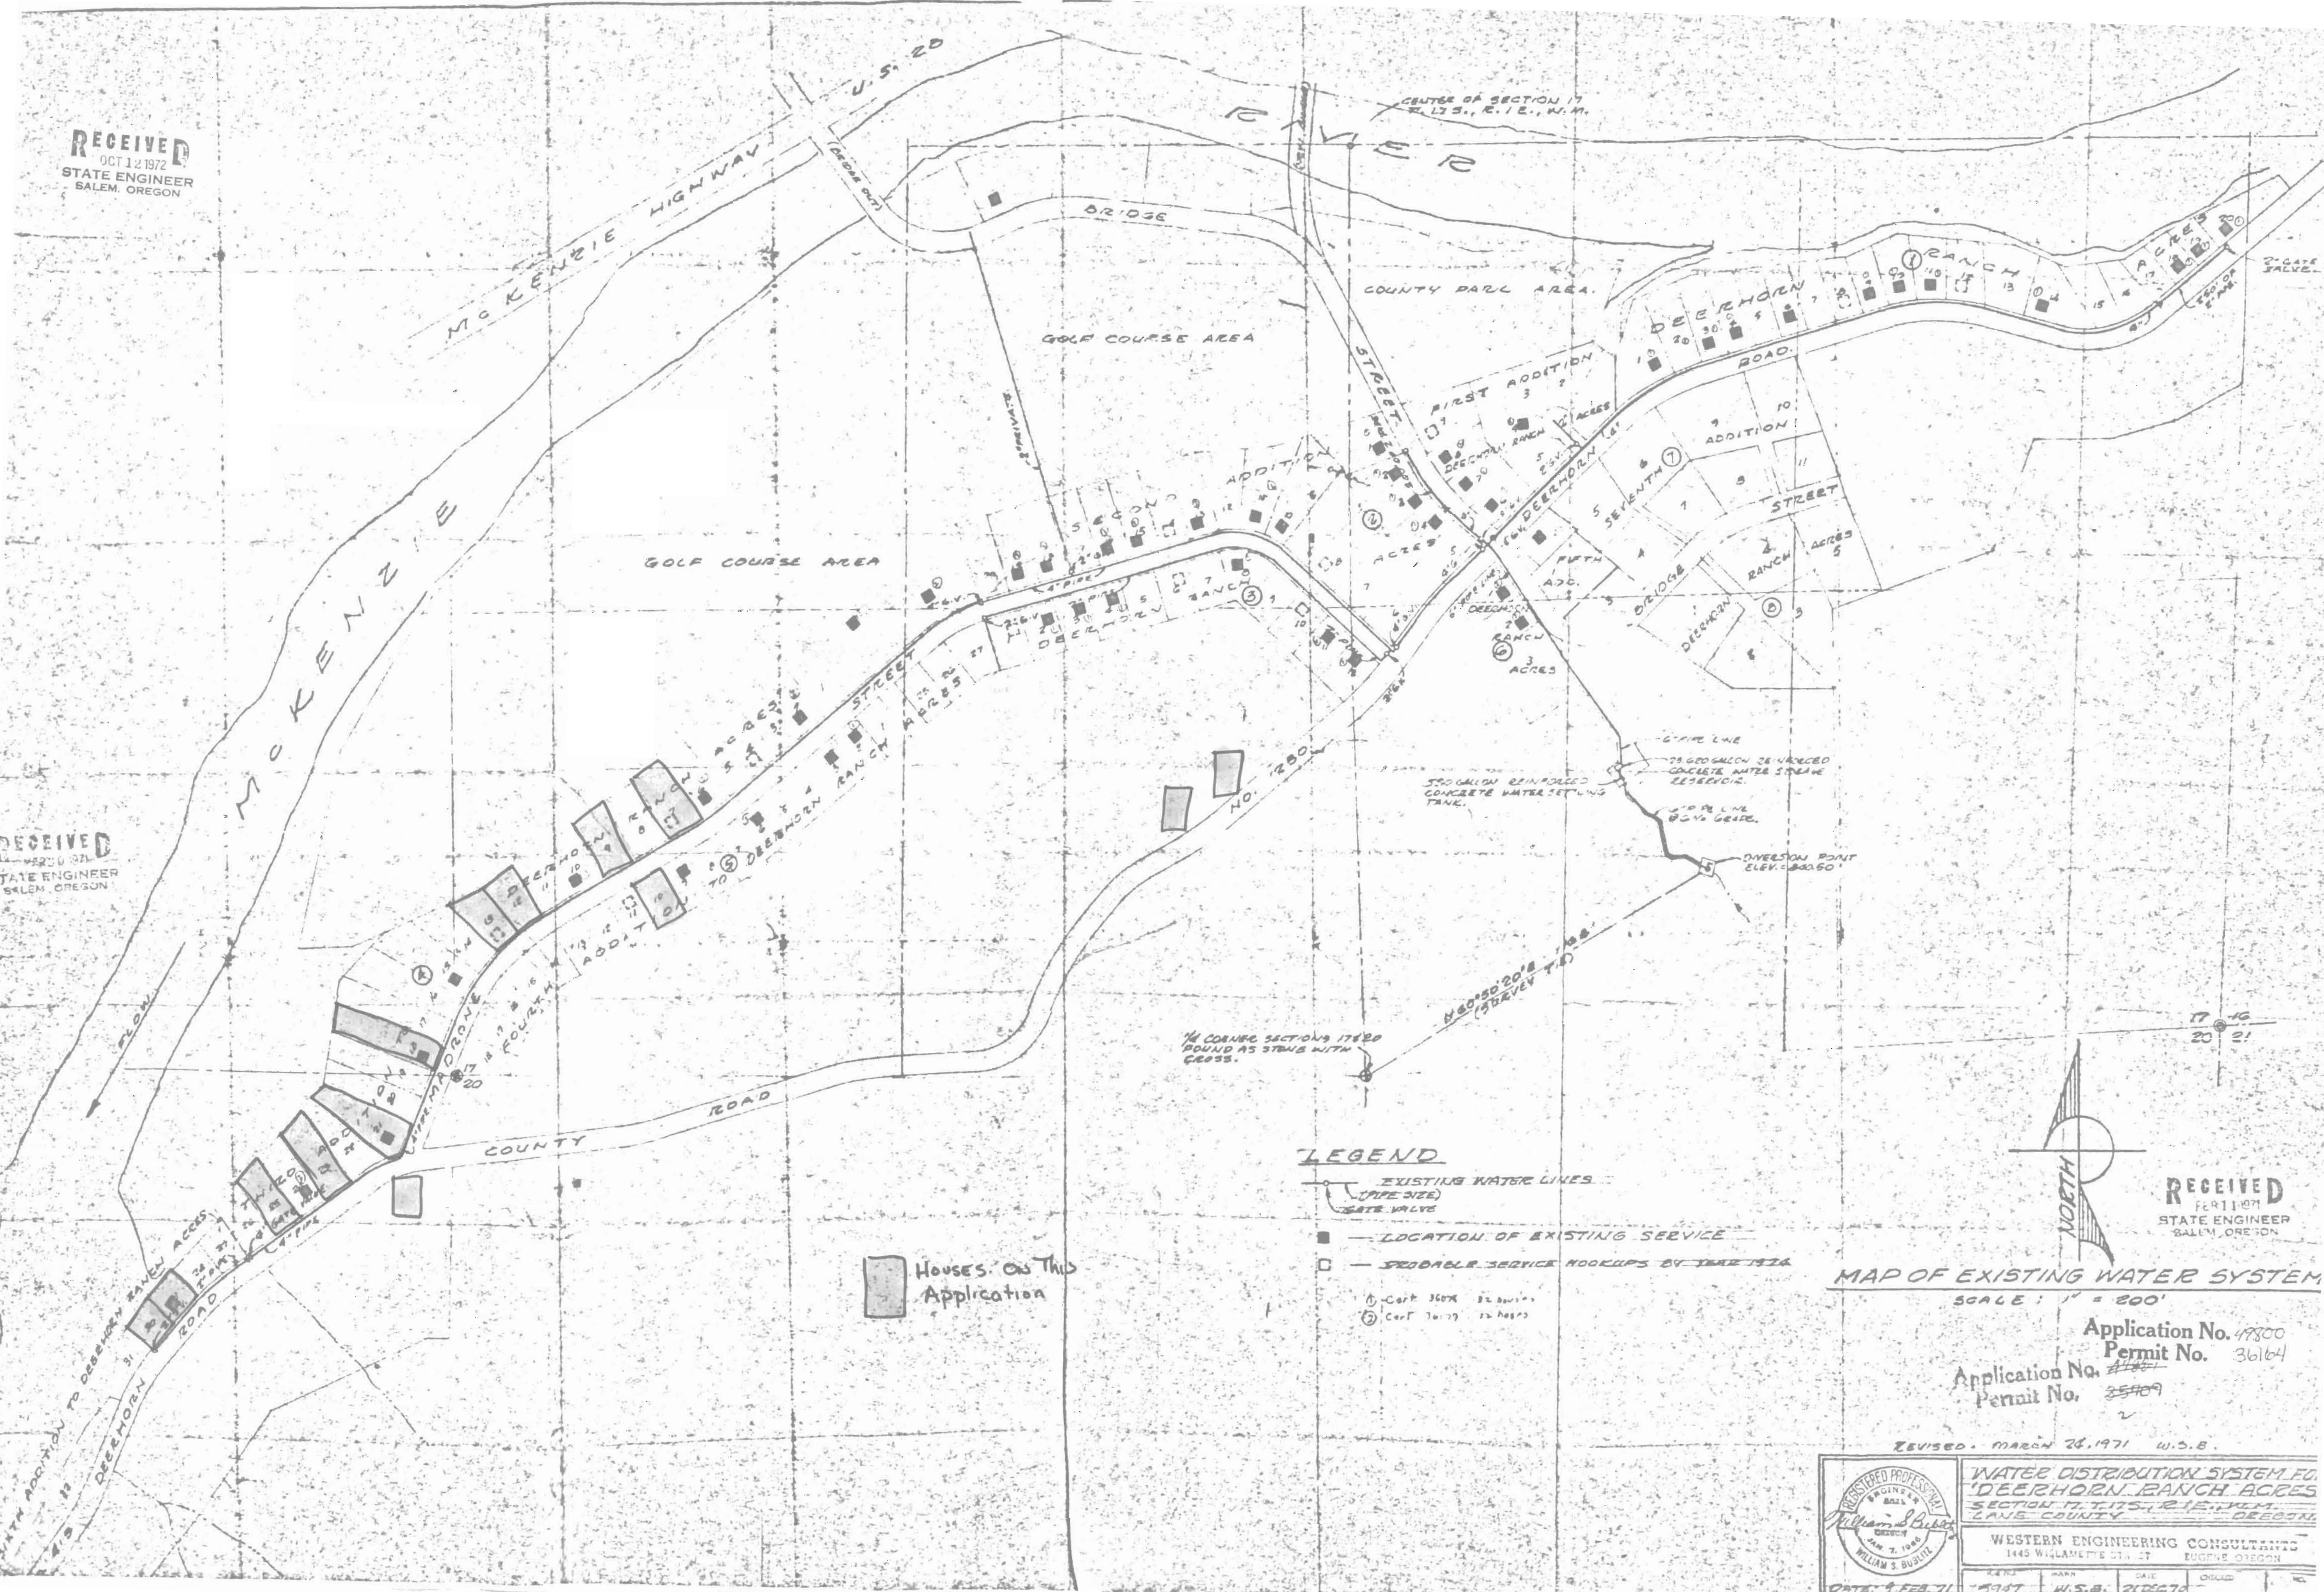

**LEGEND**

- EXISTING WATER LINES —
- (PIPE SIZE) —
- GATE VALVE —
- LOCATION OF EXISTING SERVICE —
- PROBABLE SERVICE HOOKUPS BY YEAR 1976 —
- ① - Cert 36078 22 houses
- ② - Cert 70177 25 houses

Houses on This Application

**MAP OF EXISTING WATER SYSTEM**  
SCALE: 1" = 800'

Application No. 47800  
Permit No. 36164  
Application No. ~~41661~~  
Permit No. ~~35409~~

REVISED - MARCH 28, 1971 W.S.B.



WATER DISTRIBUTION SYSTEM FOR  
DEERHORN RANCH ACRES  
SECTION 17, T. 17S., R. 12E., W. 4M.  
CLATSOP COUNTY, OREGON

WESTERN ENGINEERING CONSULTANTS  
1445 WILAMETTE ST. ST. 27  
EUGENE, OREGON

DATE: 9 FEB 71	BY: W.S.B.	DATE: 21 DEC 70	CHECKED:
----------------	------------	-----------------	----------