


# T. 26 S., R. 3 W., W.M.

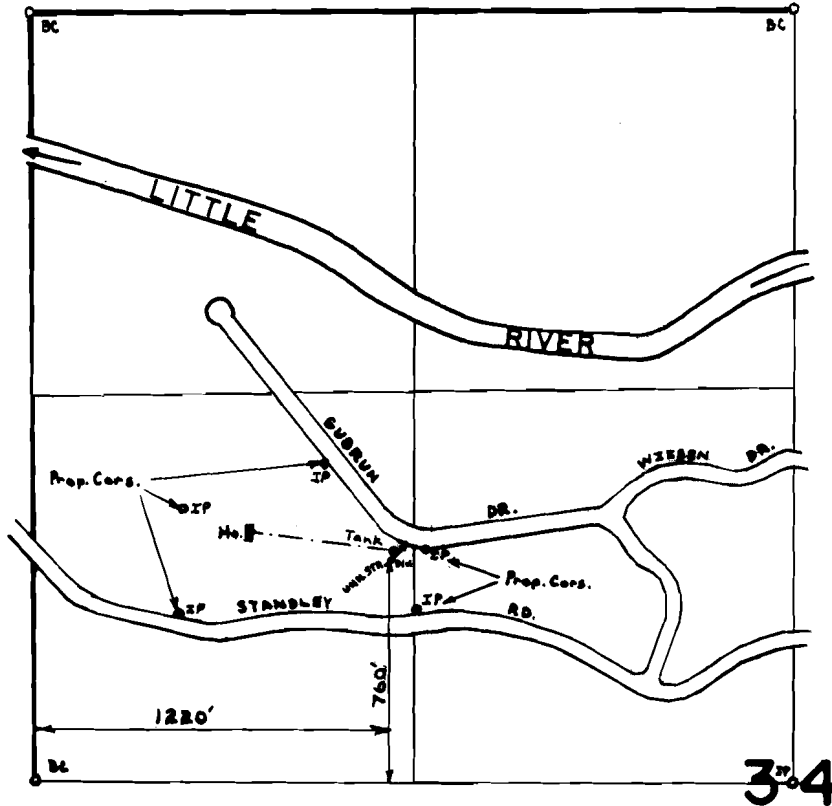

SCALE: 1" = 660'

## FINAL PROOF SURVEY UNDER

Application No. ~~56366~~ Permit No. ~~42156~~  
IN NAME OF

JAMES EDWIN McCLENDON

Surveyed MAR. 31 1978, by D.W. SPARKS