


T. 40 S., R. 3 W., W.M.

Sec. 18

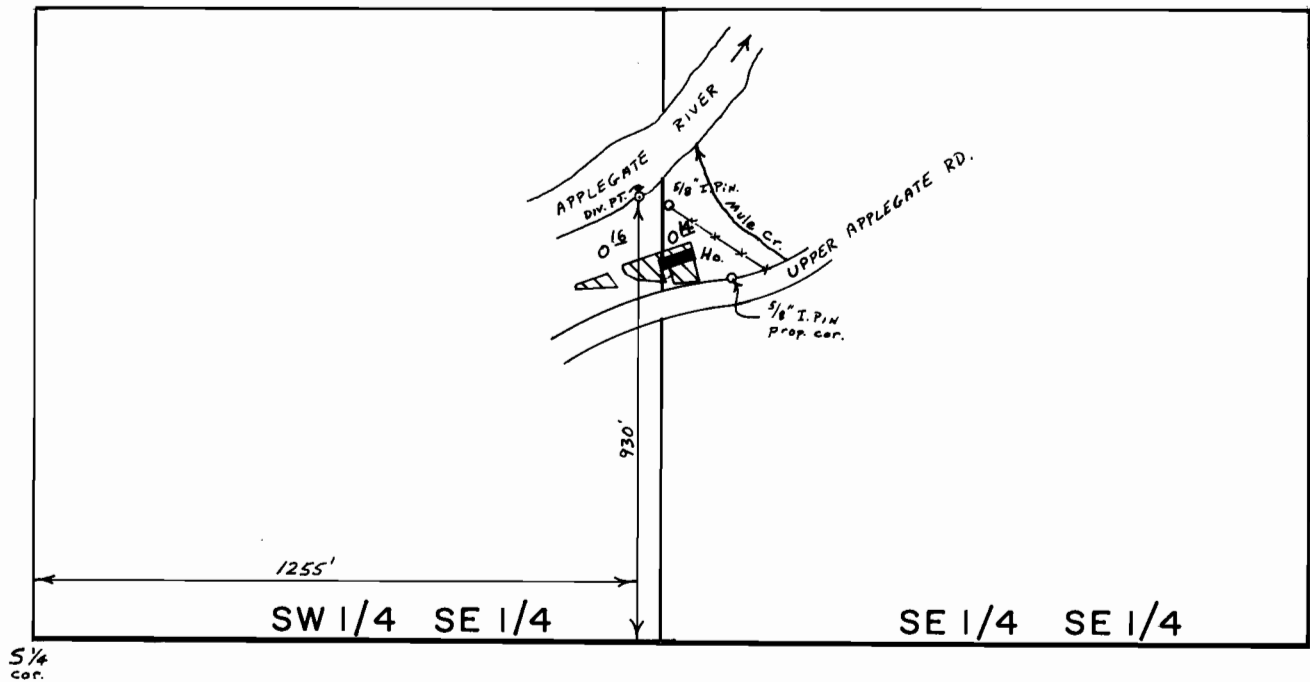

Scale 1" = 400'

**FINAL PROOF SURVEY**  
UNDER

Application No. ~~54098~~ Permit No. ~~40501~~.....  
IN NAME OF

.....LUCILLE.....BEACH.....

Surveyed ~~Sept. 24, 1980~~, by B.R. SUND.....