


T7S RIW WM

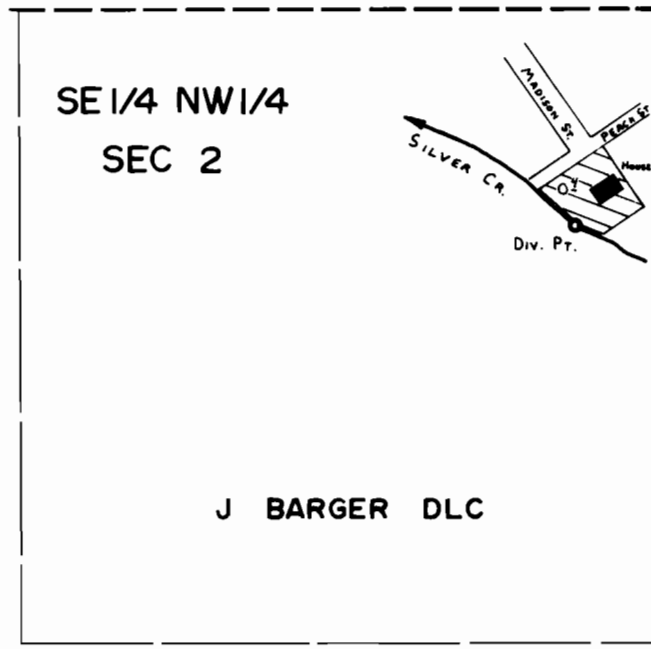

Div. Pt. Loc: 450' S. & 170' W. fr. N.E. Cor. J. BARGER DLC.
SCALE: 1" = 400'

FINAL PROOF SURVEY UNDER

Application No. ~~56196~~ Permit No. ~~42109~~.....
IN NAME OF

.....WINNONA J. HANSTAD.....

Surveyed ~~MAY 17~~ 19.78, by ~~C. L. HUGHES~~.....