


T.15S., R.12W., W. M.

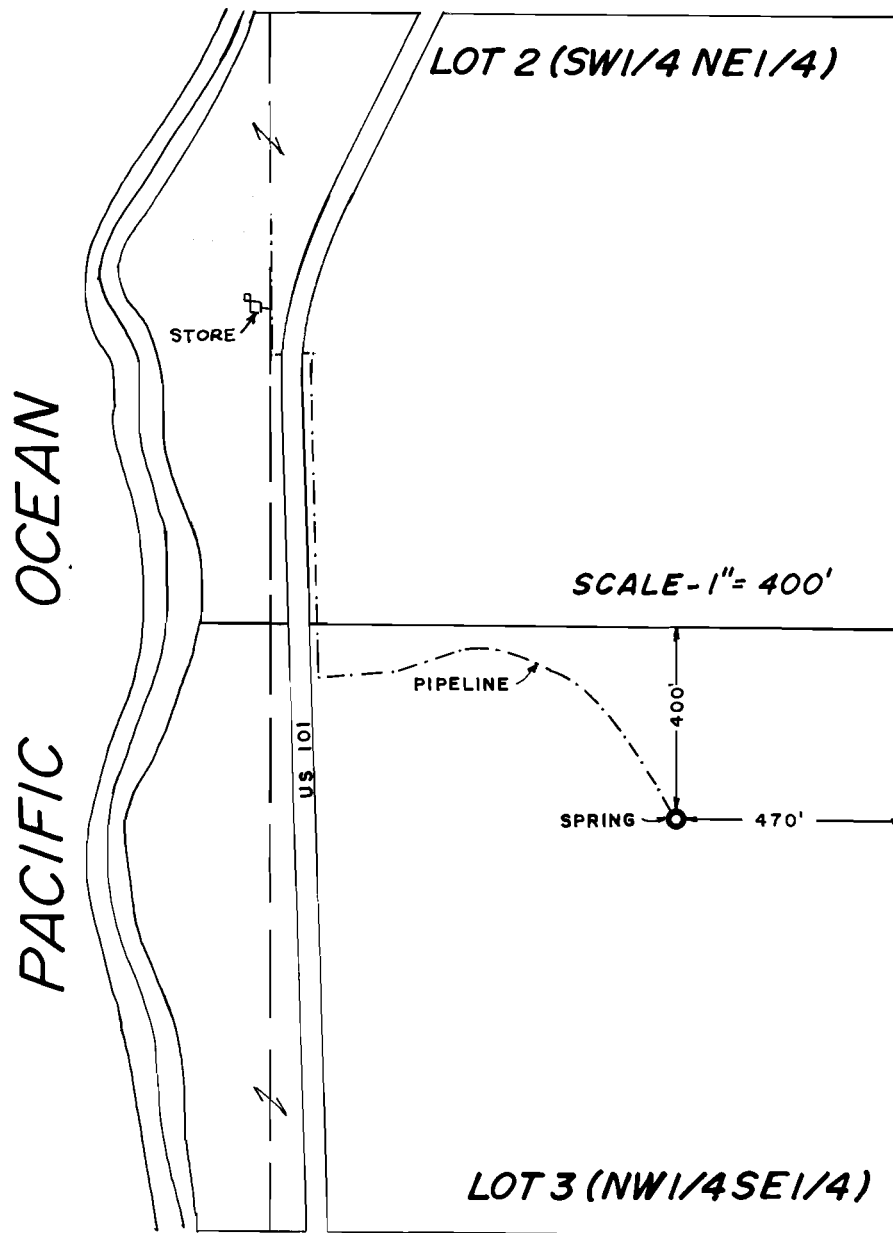

SECTION 34

SCALE: 1" = 400'

FINAL PROOF SURVEY
UNDER

Application No. ~~40347~~ Permit No. ~~30085~~....
IN NAME OF

Lloyd D. & Glenda L. Ragan

Surveyed AUG...7... 1979., by S.C.BROWN.....