


T. 5 S. R. 10 W. WM.

SCALE 1" = 400'

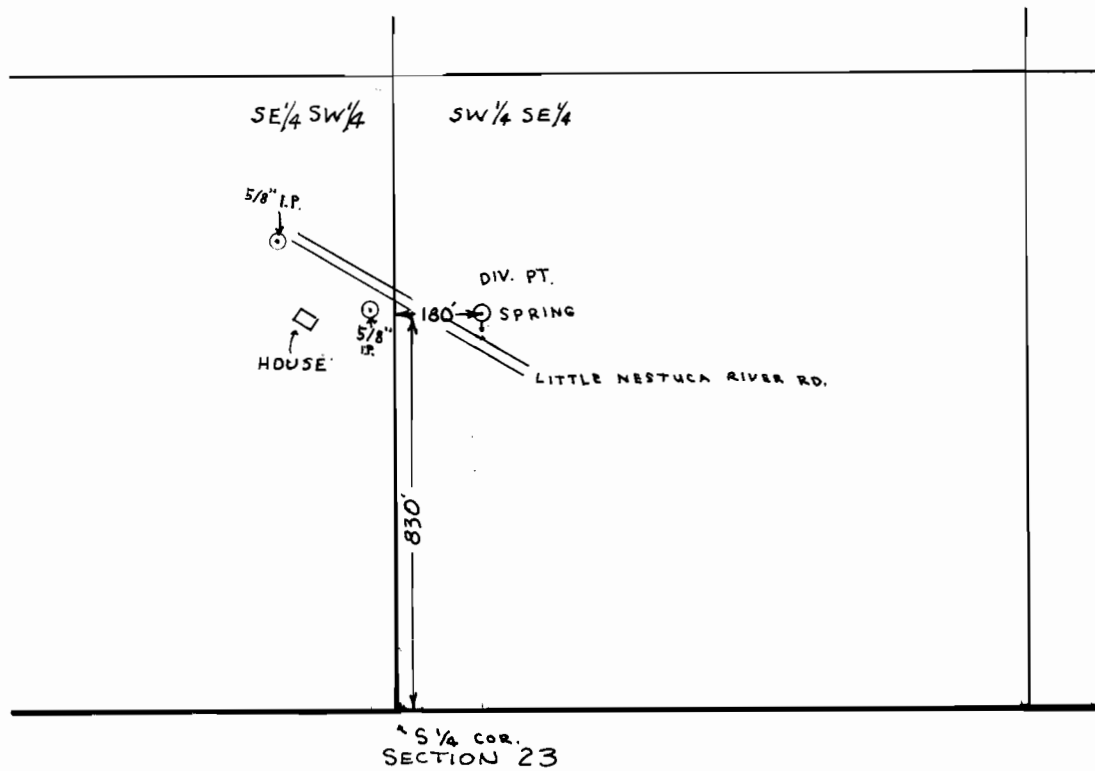

FINAL PROOF SURVEY
UNDER

Application No. ~~63558~~ Permit No. ~~47409~~.....
IN NAME OF

DANIEL C. REDDEKOPP

Surveyed OCT. 27 1983, by PAGTER, P.