


T. 7S., R. 48E., W.M.



Div. Pt. Loc: 700'S. & 1380' E FROM NW COR SEC 20

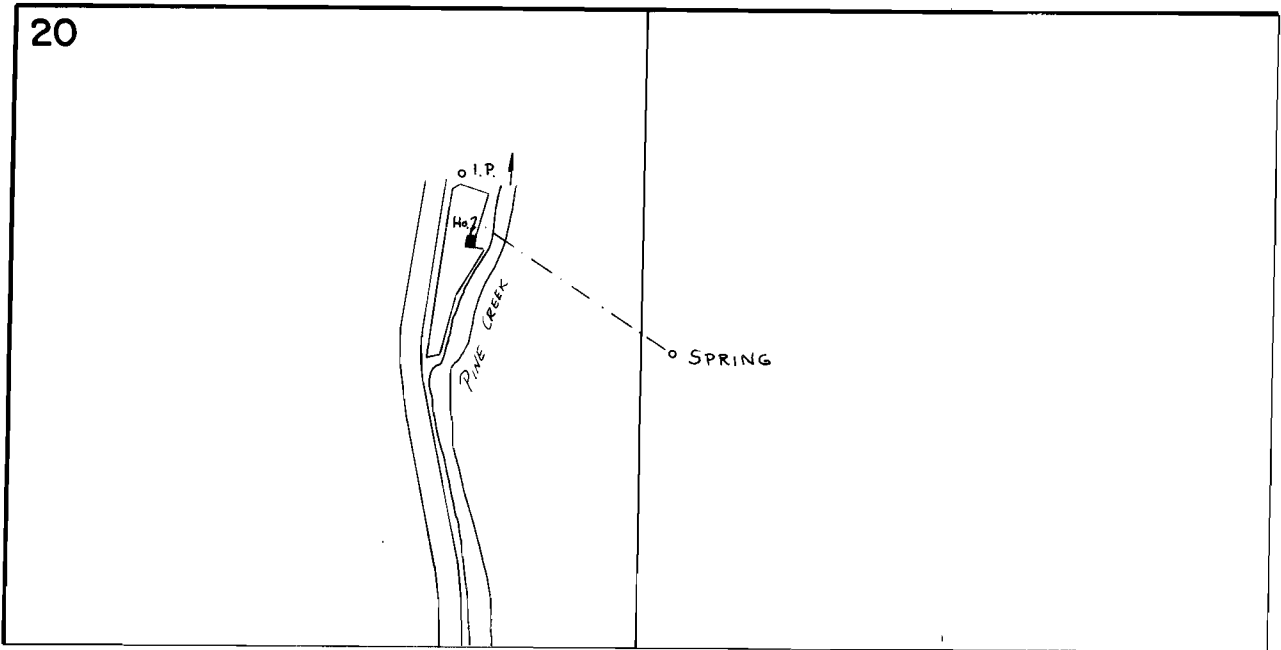

FINAL PROOF SURVEY
UNDER

SCALE: 1" = 400'

Application No. **65270** Permit No. **47902**...
IN NAME OF

.....**DONALD L. BAKER**.....

Surveyed ~~5-23~~..... **19.84**, by ~~V. b. Church~~.....