

FOR: ROBERT SCHMIDT
RT. 1, BOX 466
WOODBURN, OREGON 97071

Location No. ~~G-6978~~ ~~G-5888~~ G-7801
52393


RECEIVED

JUN 27 1977

WATER RESOURCES DEPT.
SALEM, OREGON

TOWNSHIP 5 SOUTH, RANGE 2 WEST, W.M.
SECTIONS 2, 3, 10 & 11

SALEM, OREGON

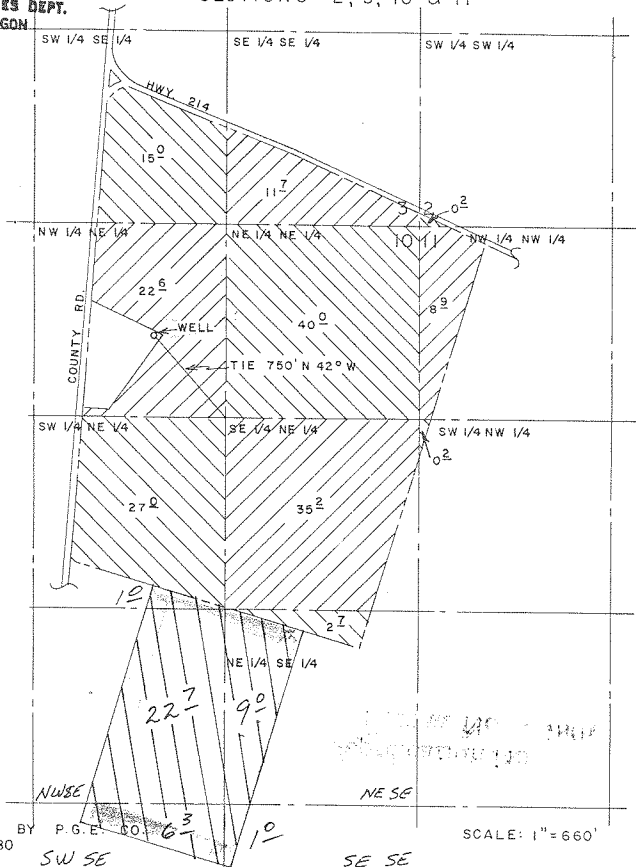

THIS I PREPARED BY:
Dorothy Haring
FROM INFORMATION FURNISHED BY
THE APPLICANT.

PREPARED BY P.G.E. CO.
DFN-2DD-180

SCALE: 1" = 660'



THIS APPLICATION

Application No. G-82011
Permit No. G 7801