


T.30S., R.12W., WM.  
SEC. 8

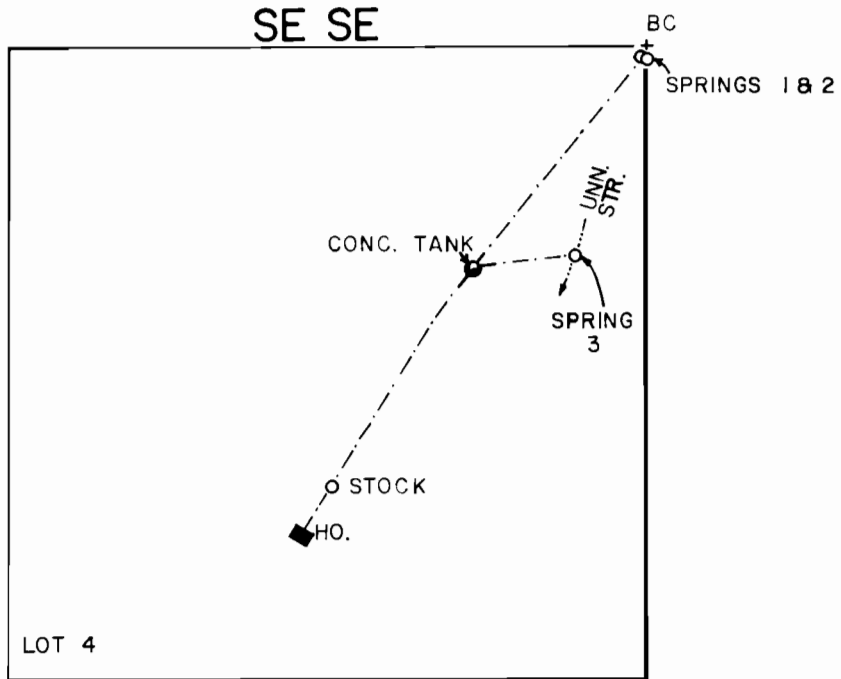

SPRING 1 LOCATED 20'S. and 10'W.  
SPRING 2 LOCATED 30'S. and 0'W.  
SPRING 3 LOCATED 440'S. and 150'W.  
ALL FROM N.E. CORNER LOT 4.

SCALE: 1" = 400'

**FINAL PROOF SURVEY**  
UNDER

Application No. ~~49416~~... Permit No. ~~37029~~.....  
IN NAME OF

**EDWIN WEEKLY**

Surveyed ~~JULY 23, 1980~~, by ~~J.S. DONALDSON~~  
SEPT. 13, 1984 L. CASHION