


T.13S.R.1E.W.M.

SECTION 19

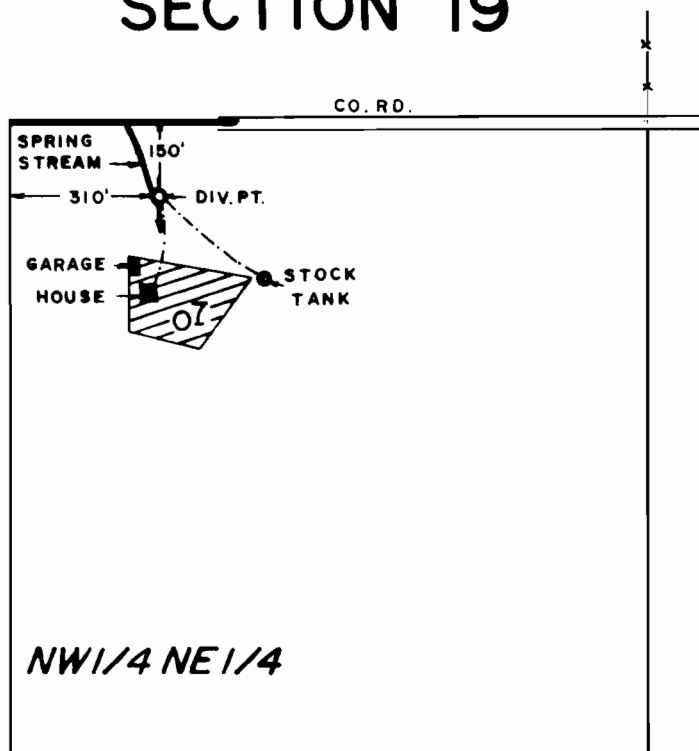

Scale 1" = 400'

FINAL PROOF SURVEY UNDER

Application No. ~~46708~~ Permit No. ~~34904~~....
IN NAME OF

~~VERNON & RAGNA ANDERSEN~~.....

Surveyed Aug. 2, 1979, by S.C. BROWN.....