


T.30S., R.6W., W.M.

SEC. 34

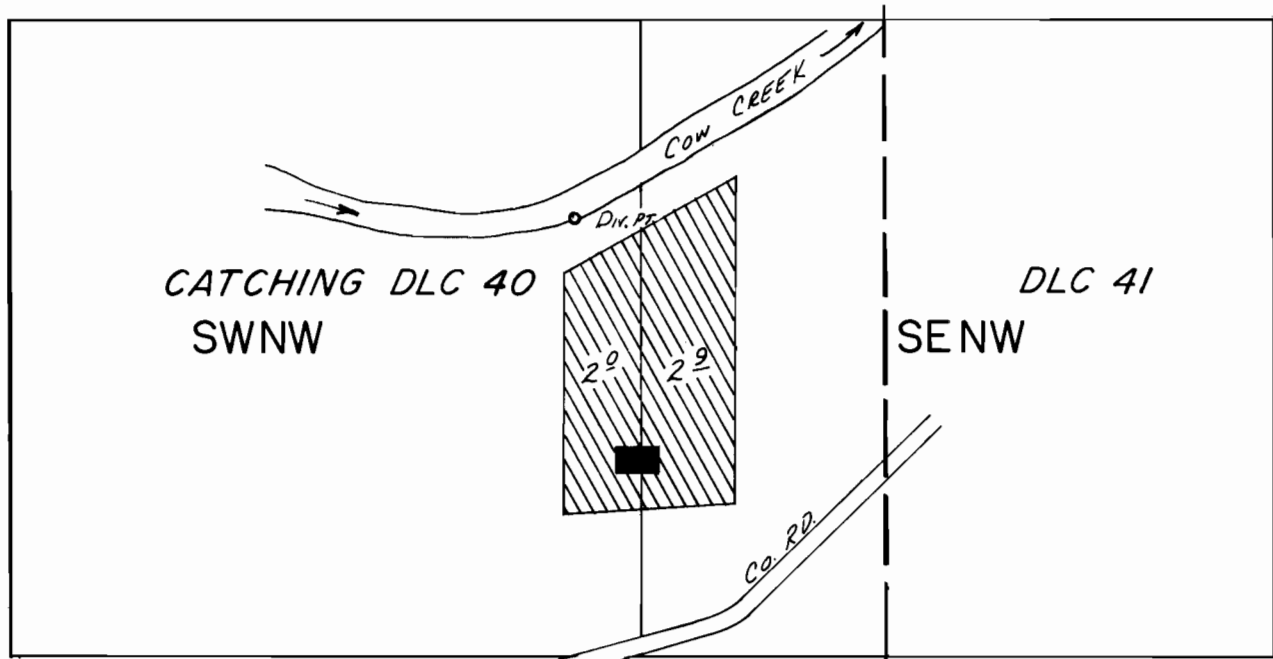

*Div. Pt. Loc.: 910' N. & 1180' E. FROM W 1/4 COR. SEC. 34.*

SCALE: 1" = 400'

**FINAL PROOF SURVEY**  
UNDER

Application No. ~~56306~~ Permit No. ~~42385~~.....  
IN NAME OF

.....**LAWRENCE RAMSEY**.....

Surveyed ~~JUNE 23~~ 1980, by ~~J.S. DONALDSON~~