


T.4S. R2E. W.M.

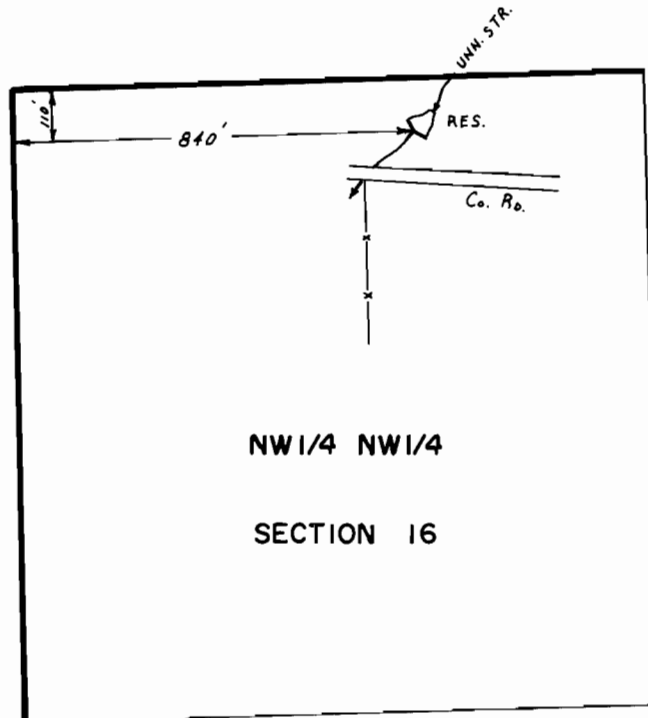

SCALE: 1" = 400'

FINAL PROOF SURVEY
UNDER

R-52419 R-6311
Application No. ~~52420~~ Permit No. ~~39429~~....
IN NAME OF

JOHN CHAMP

Surveyed Oct. 10, 1979, by C. L. HUGHES....