


T.4S. R2E. W.M.

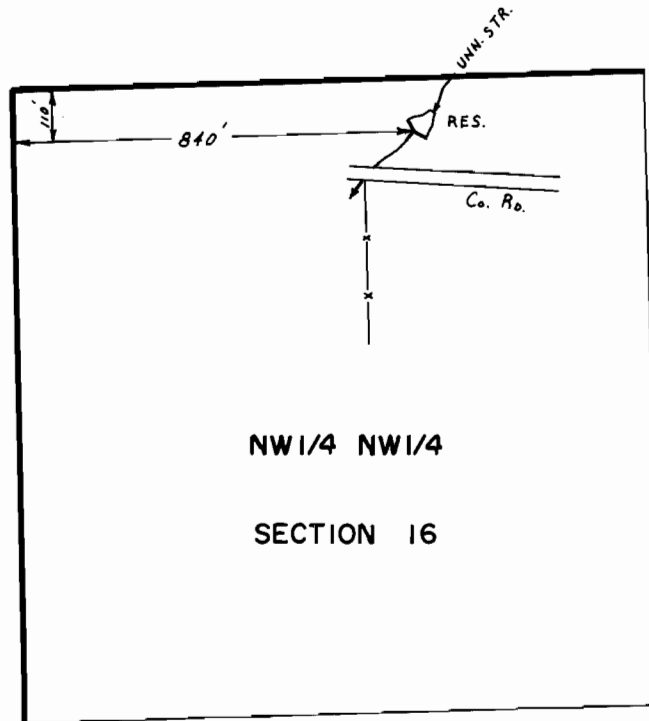

SCALE: 1" = 400'

**FINAL PROOF SURVEY**  
UNDER

R-52419                      R-6311  
Application No. ~~52420~~ Permit No. ~~39429~~....  
IN NAME OF

**JOHN CHAMP**

Surveyed Oct. 10, 1979, by C. L. HUGHES....