


T.36S., R.2W., W.M.

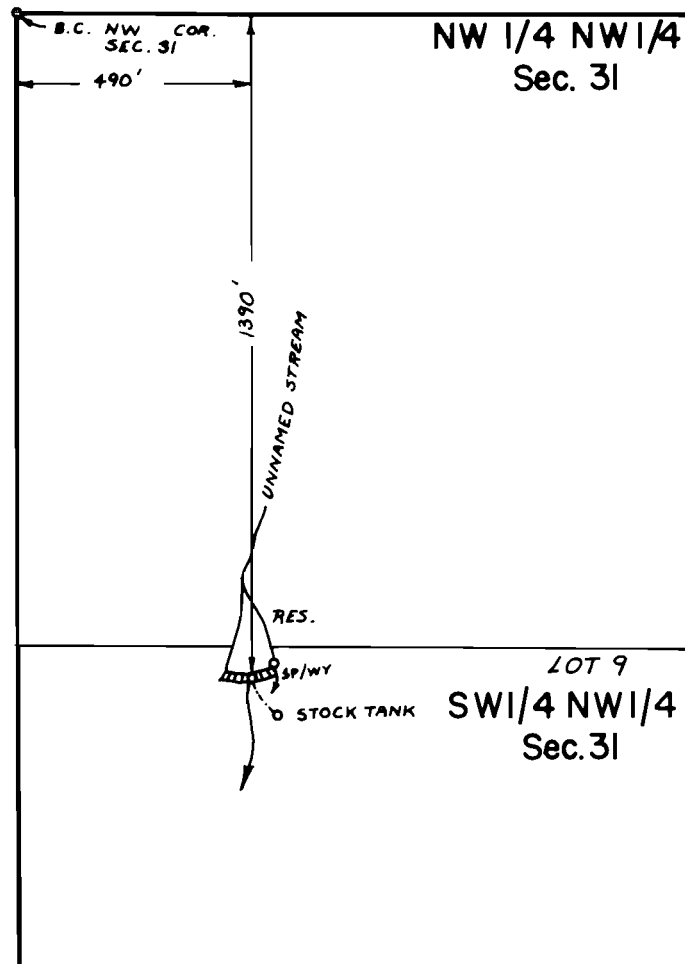

Scale 1" = 400'

FINAL PROOF SURVEY UNDER

R-53346 R-6206
Application No. ~~53347~~... Permit No. ~~30633~~.....
IN NAME OF

.....LARUE.....MORRIS.....

Surveyed July 24, 1980, by B.R. SUND.....