

DEC 2 1981

WATER RESOURCES D
S CAL O. S OREGON

A SURVEYED PLAT OF THE SOUTHERN PORTION OF THE PROPERTY OF ROBERT TURK SHOWING THE POSITION OF THE WATER SUPPLY AND THE LOCATION OF HIS HOUSE. NW 1/4, SECTION 7, T4N, R10W, WM., CLATSOP COUNTY, OREGON

SCALE : 1" = 200'

DATE: DEC. 1, 1981

Application No. 63230

Permit No. 46706


Application No. ~~63055~~

Permit No. ~~46152~~

RECEIVED

JAN 28 1982

WATER RESOURCES DEPT.
SALEM, OREGON

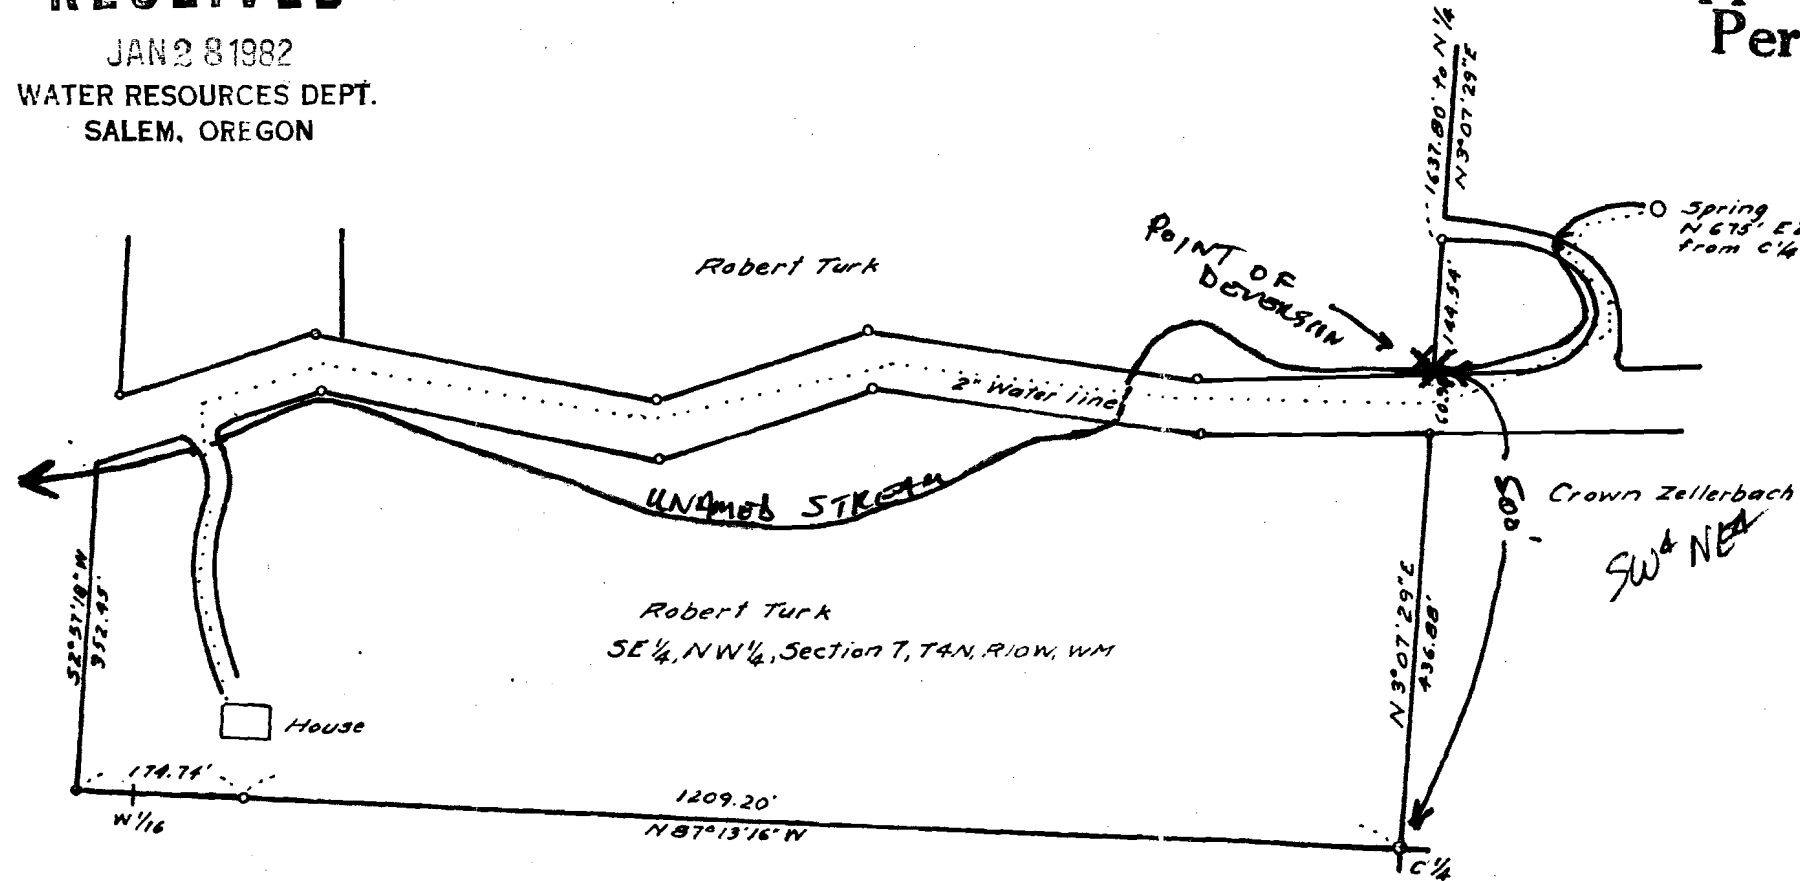

**REGISTERED
PROFESSIONAL
LAND SURVEYOR**

Tom B. Wagner

OREGON
SEPTEMBER 21 9
TOM B. WAGNER
1379