


T.20S., R.5W., W.M.

Section 1



Div. Pt. Loc.: 900' N. & 160' W. FROM SE COR. CROW DLC 38.

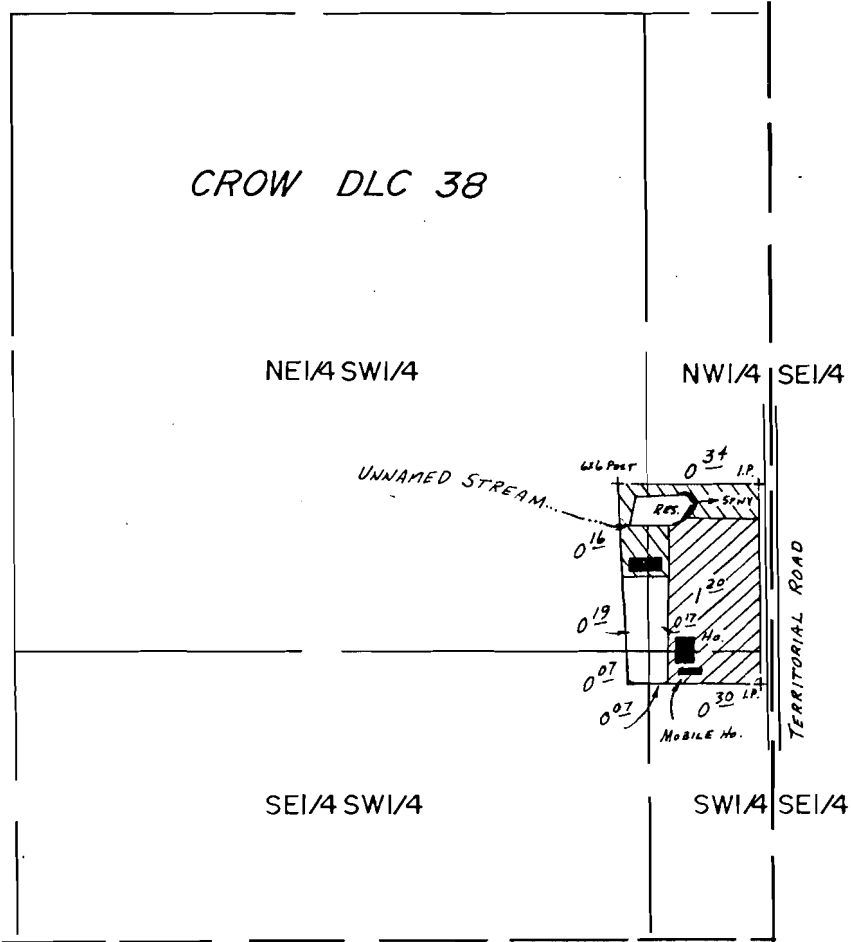

Primary

Supplemental

SCALE: 1" = 400'

**FINAL PROOF SURVEY**  
UNDER

R-60948

R-8385

Application No. ~~60949~~ Permit No. ~~46582~~.....

IN NAME OF

CLIFFORD W. & DARLENE J. STEVENS

Surveyed Sept. 25, 1985, by B.W. BISHOP.....

5/8/86  
BWB

PTS 1985-L