


T.2N., R.10E., W.M.  
SECTION 21

1/4 COR.

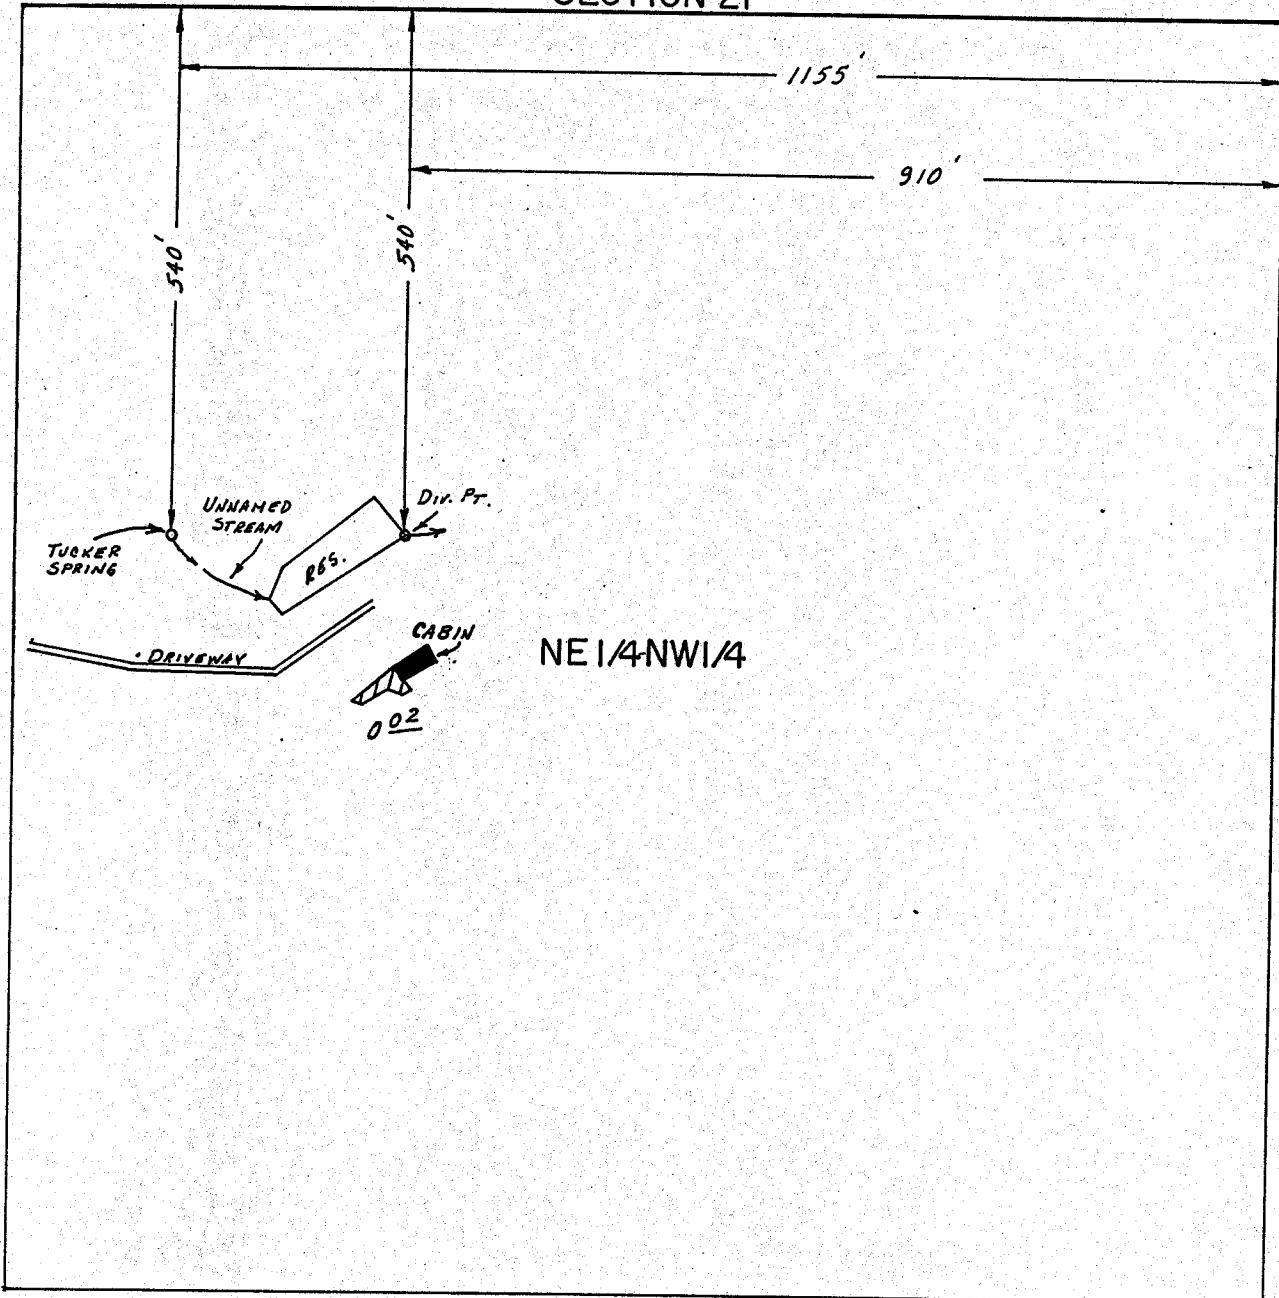

SCALE: 1" = 200'

**FINAL PROOF SURVEY**  
UNDER

R-67896                      R-10034  
Application No. ~~67698~~ Permit No. ~~48954~~  
IN NAME OF

..... IOLA B. HICKOCK .....

Surveyed Aug. 27, 1985, by T.M. WARREN.....