


T. 34 S., R. 1 W., W.M.

Sec. 15

NE 1/4 SW 1/4

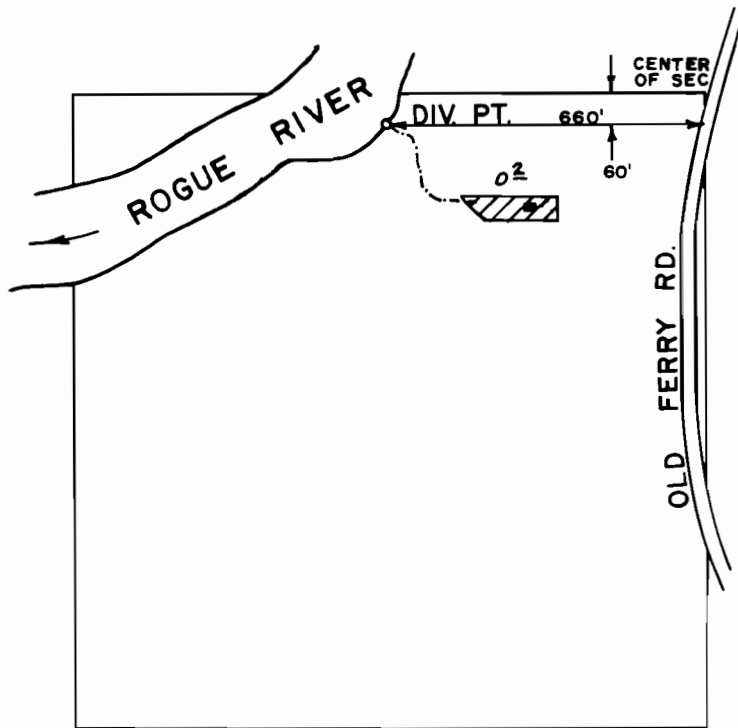

FINAL PROOF SURVEY

UNDER

Application No. ~~46057~~ Permit No. ~~34394~~.....
IN NAME OF

.....
Surveyed Nov. 4, 1982, by B.S. JAMES.....

SCALE 1" = 400'