


T. 34 S., R. 5 W., W.M.

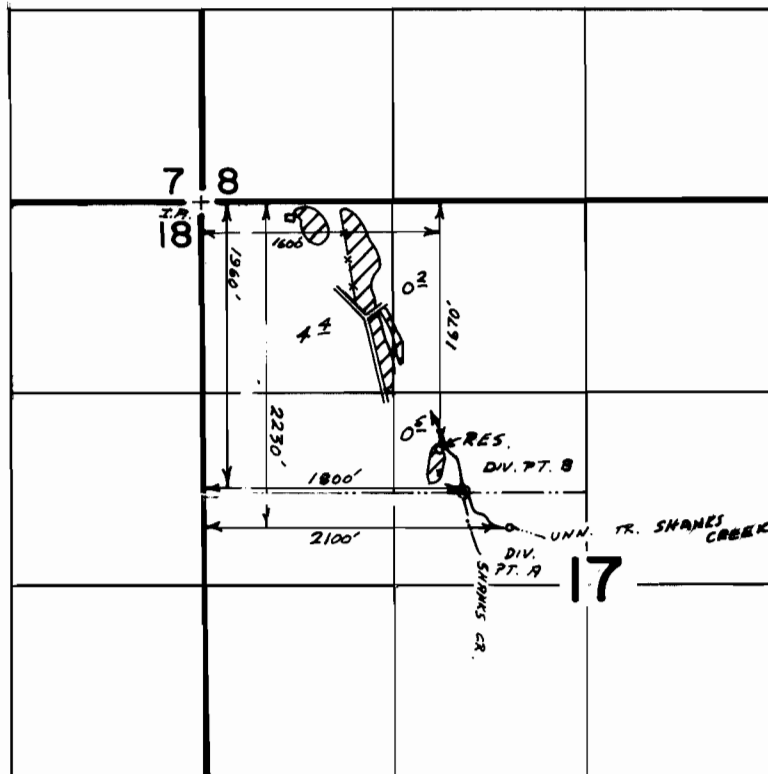

Scale 1" = 400'

FINAL PROOF SURVEY
UNDER

R-50369 R-6080
Application No. ~~50370~~ Permit No. ~~37421~~.....
IN NAME OF
.....**DAVID**.....**ALLEN**.....**GAUNT**.....
Surveyed Aug...11... 1986, by B.S...**JAMES**.....