


Application No. G10642
 Permit No. G 9984

REDUCED COPY
 NOT TO SCALE



DAVID MCNUTT
 D.L.C. NO. 75
 20855
 JOHN KIZER
 P.L.C. NO. 52

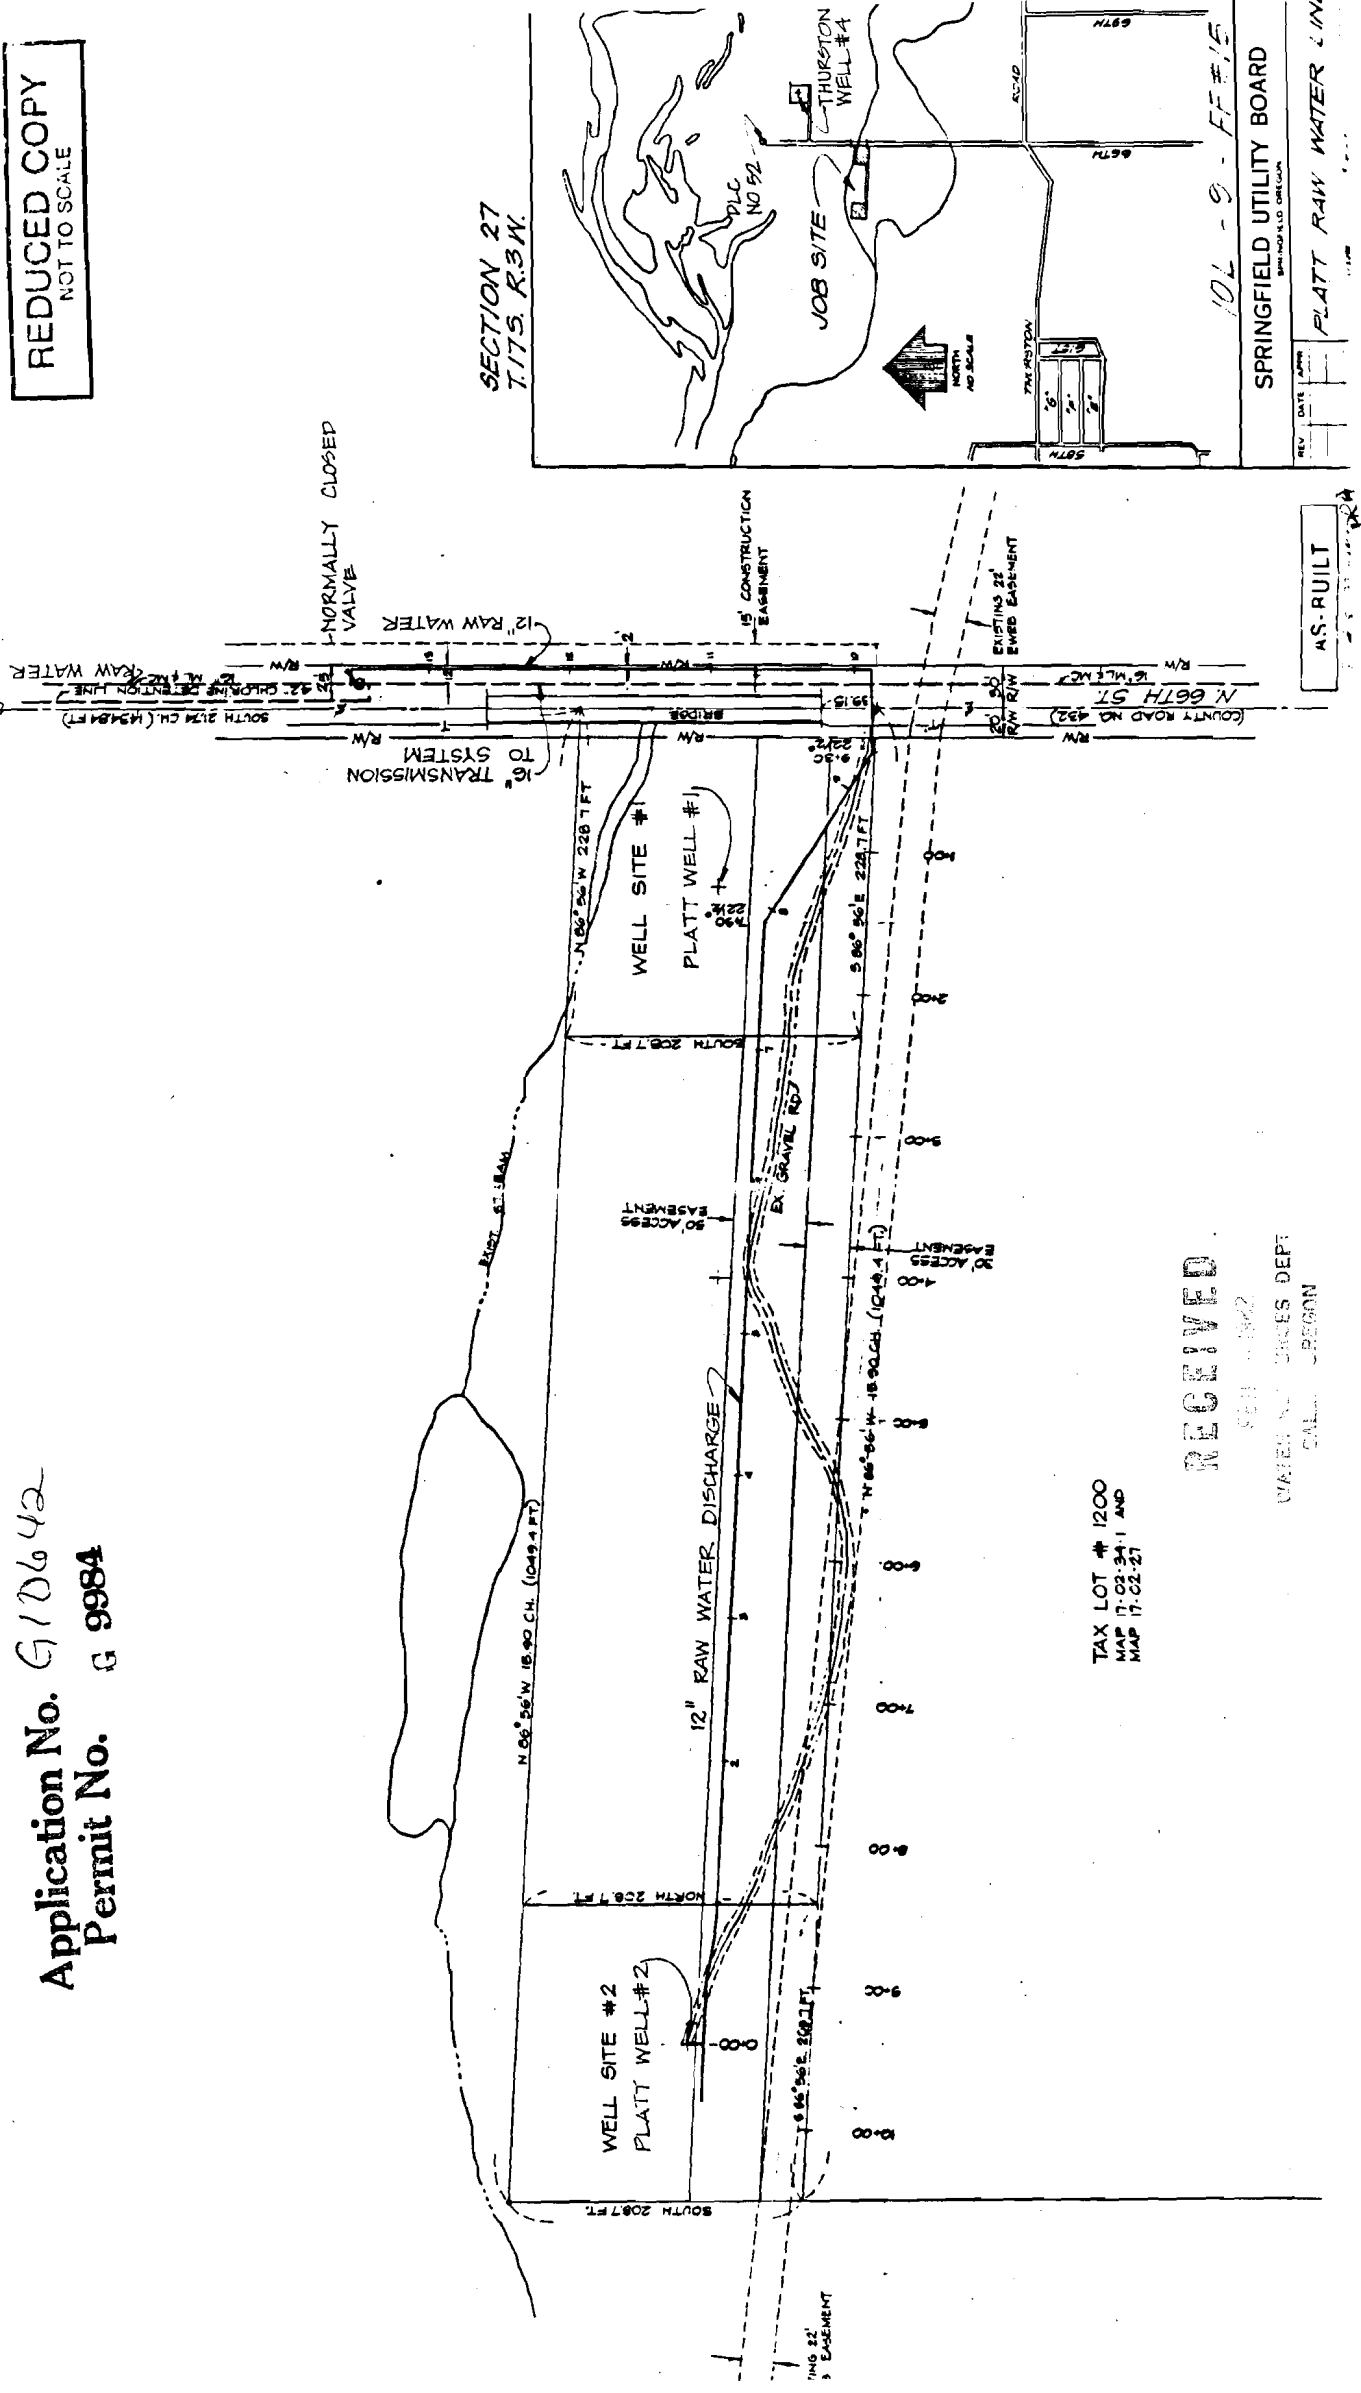

SECTION 27
 T.175. R.3W.

10L-9-FF#15

SPRINGFIELD UTILITY BOARD
 500 N. 10th St. OREGON
 PLATT RAW WATER LINE

AS-BUILT

TAX LOT # 1200
 MAP 17-02-34-1 AND
 MAP 17-02-27

RECEIVED

508-3802
 WATER UTILITIES DEPT
 CALL CREGAN