


Application No. 910643
 Permit No. 9985

RECEIVED

APR 11 1987
 WATER SALES DEPT
 OREGON

TAX LOT # 1200
 MAP 17-02-34-1 AND
 MAP 17-02-21

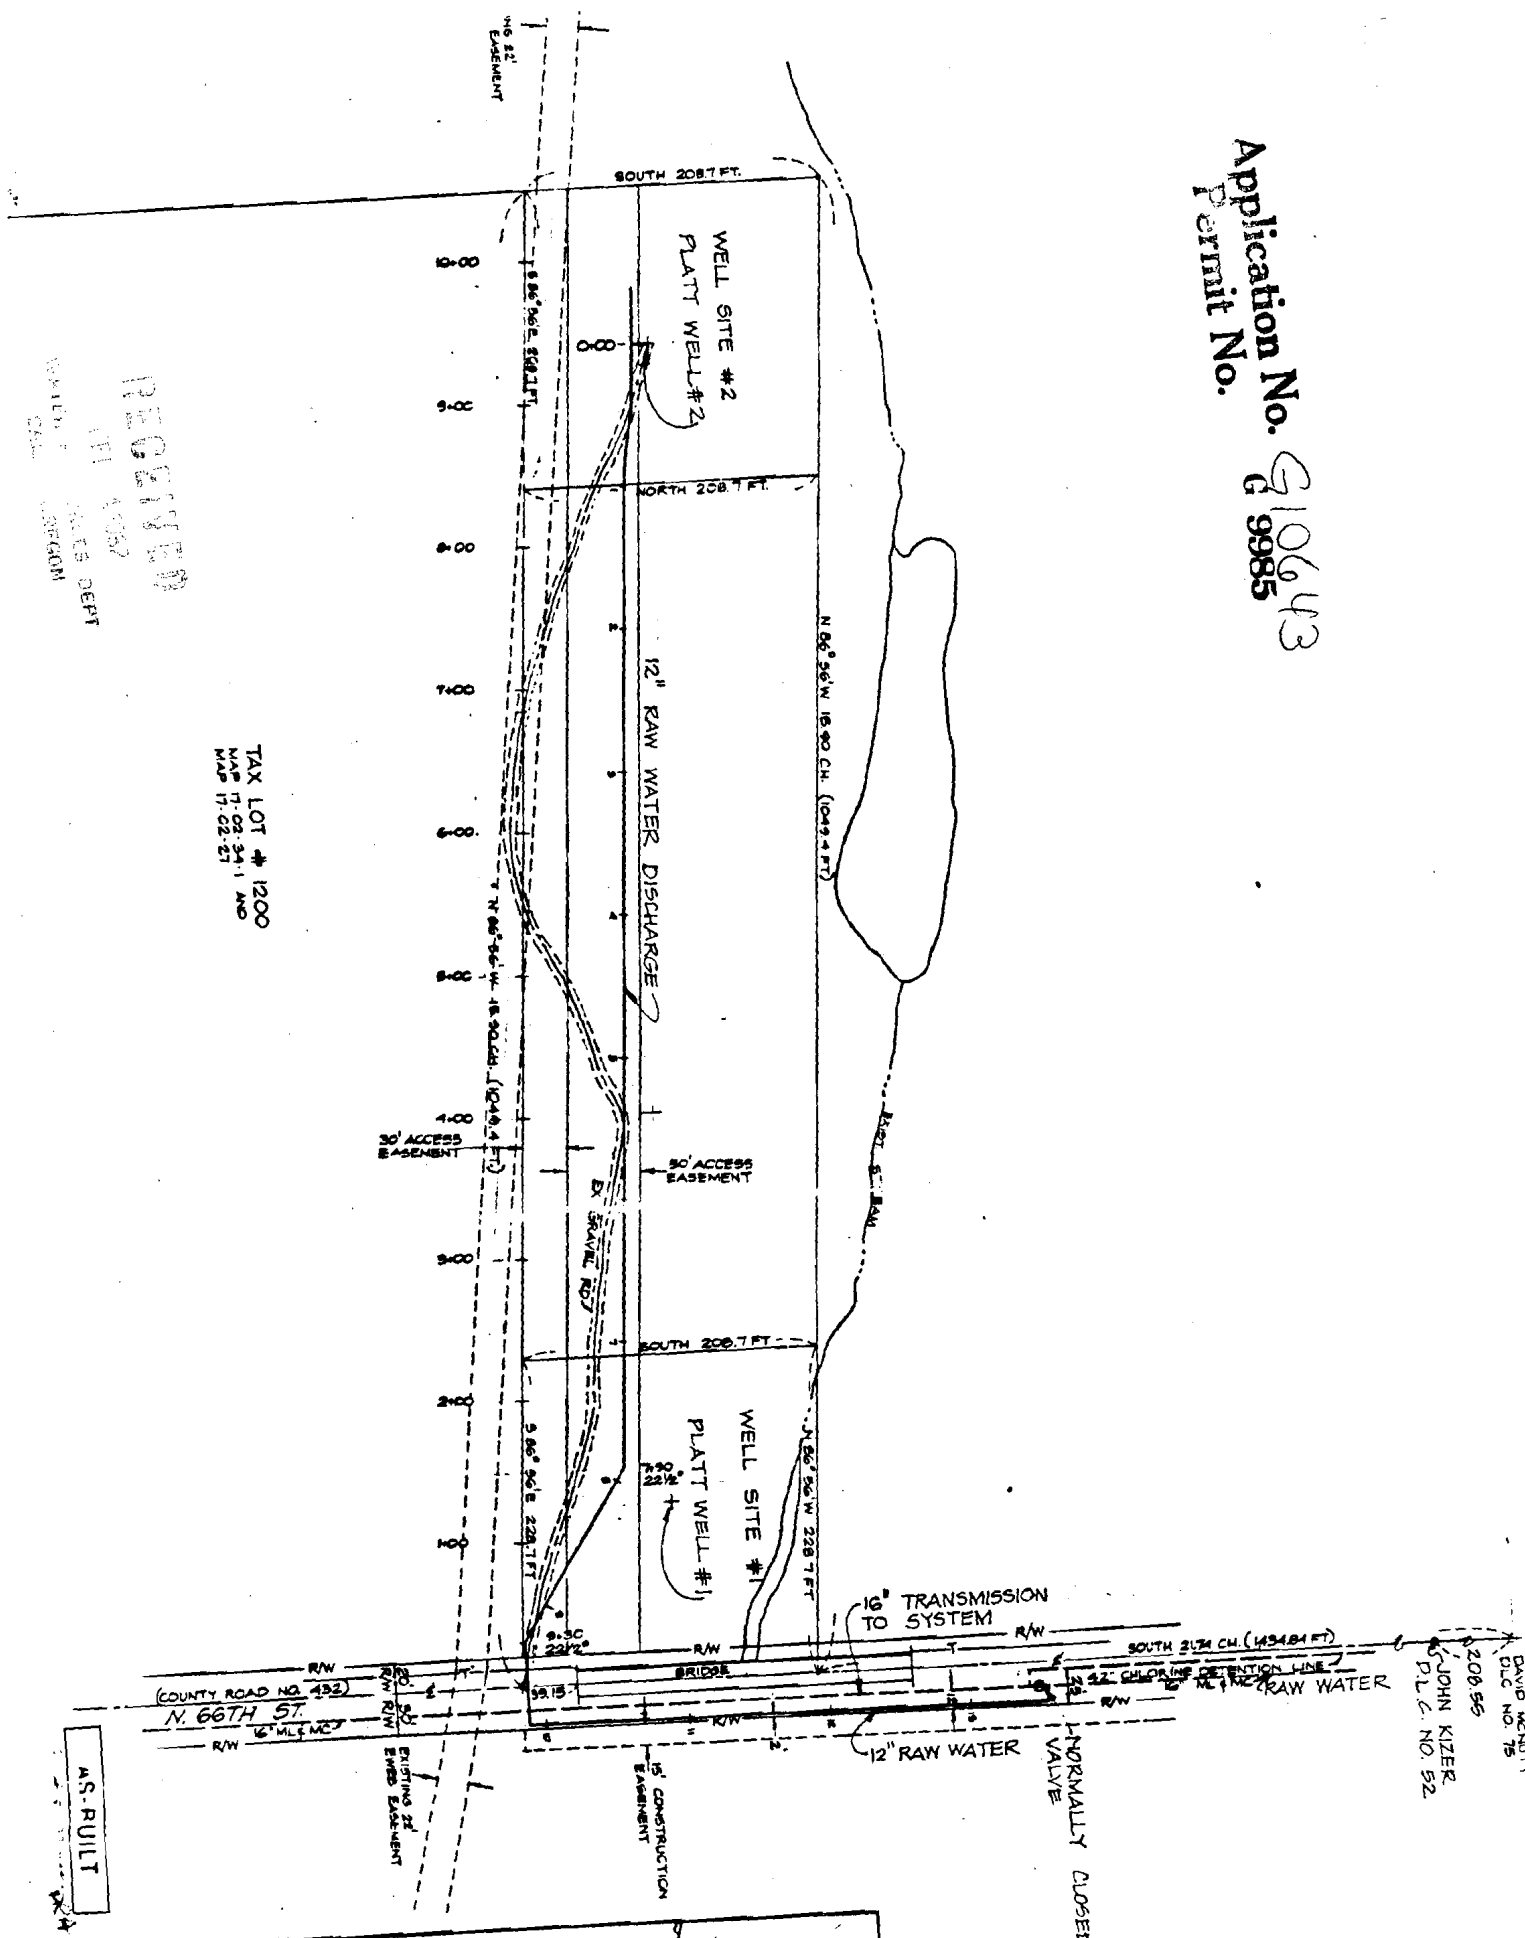

DAVID MCINTYRE
 D.L.C. NO. 75
 JOHN KIZER
 D.L.C. NO. 52

AS-BUILT

REDUCED COPY
 NOT TO SCALE

