


MAP

SHOWING A HYDROGRAPHIC SURVEY OF A LAKE IN ROGUE LEA ESTATES NORTH, PLANNED DEVELOPMENT IN THE NE 1/4, NW 1/4 OF SECTION 24, T. 36 S., R. 6 W., W.M., JOSEPHINE COUNTY, OREGON

APRIL 1, 1981
SCALE: 1" = 50'

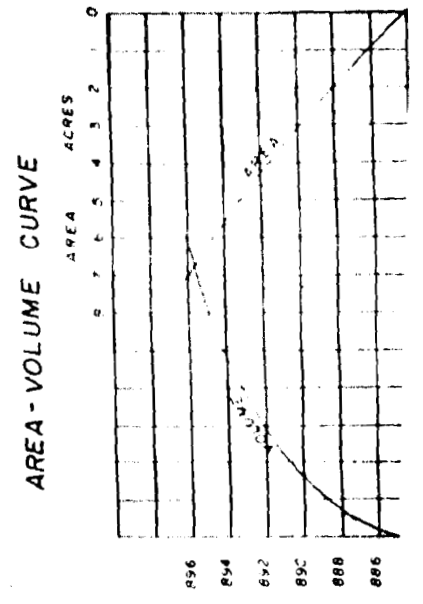

Application No. R-59190, 61643
Permit No. R 8354 46461

CURRENT WATER VOLUME = 38.5 ACRE FEET
TOTAL WATER CAPACITY = 55.00 ACRE FEET
AREA = 7.00 ACRES

RECEIVED
APR 20 1981
WATER RESOURCES DEPT
SALEM, OREGON

SURVEYED BY:
MAX H HULL, SURVEYING
231 NW "B" STREET
GRANTS PASS, OR

SURVEYED FOR:
VANCE MEANS
~~PO BOX 1174~~
~~REAGERSVILLE, OR~~
2275 WEBSTER ROAD
GRANTS PASS, OR.

Max Hull