


T.14S., R.8W., W.M.
NW 1/4 SW 1/4
SECTION 24

1/4 Cor.

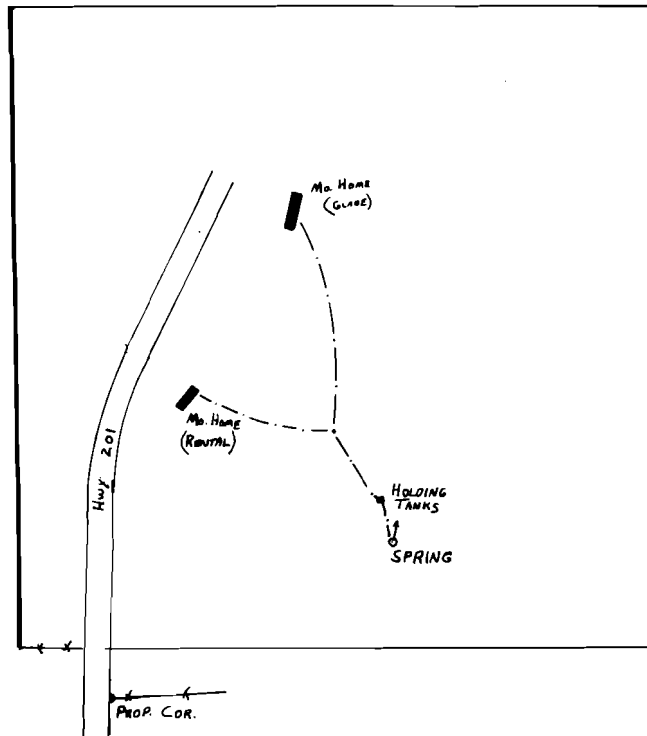

Scale: 1" = 400'

Spring Loc.: 1100' S. & 780' E. from the W. 1/4 Cor. Sec. 24.

FINAL PROOF SURVEY
UNDER

Application No. ~~58859~~.. Permit No. ~~44352~~.....
IN NAME OF

STEVEN RICHARD GLADE.....

Surveyed JUNE 21, 1983, by L. TOLL.....