


T.29 S., R.6 W., W.M.  
SEC. 22

SCALE: 1" = 400'

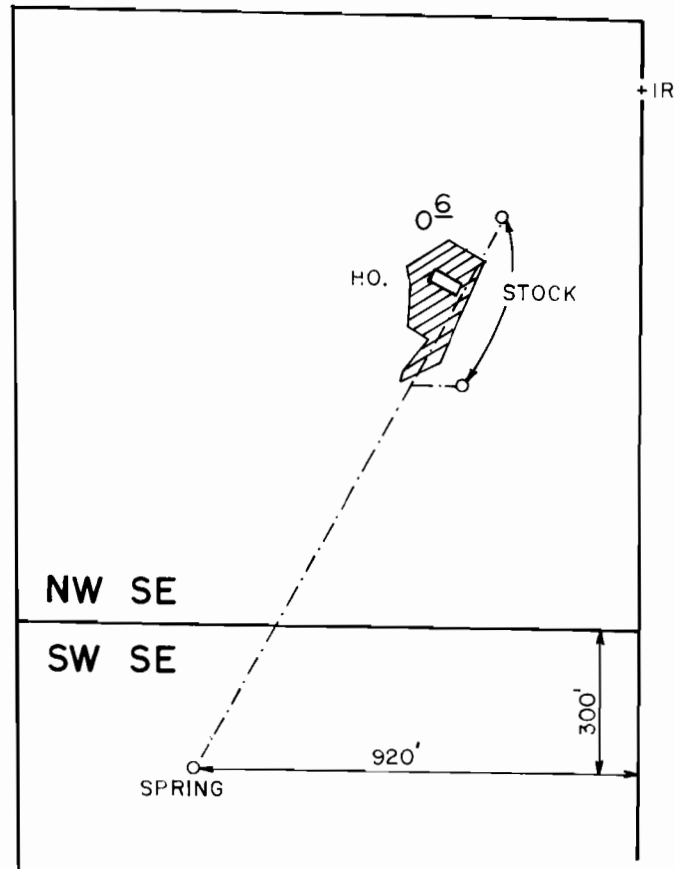

**FINAL PROOF SURVEY**  
UNDER

Application No. ~~59690~~ Permit No. ~~44846~~.....  
IN NAME OF

.....**LEE H. SCHULTZ**.....

Surveyed JAN. 25, 1984, by *L. E. Cashion*.....  
SEPT 26, 1984