


T. 13 S., R. 9 E., W. M.

SECTION 15

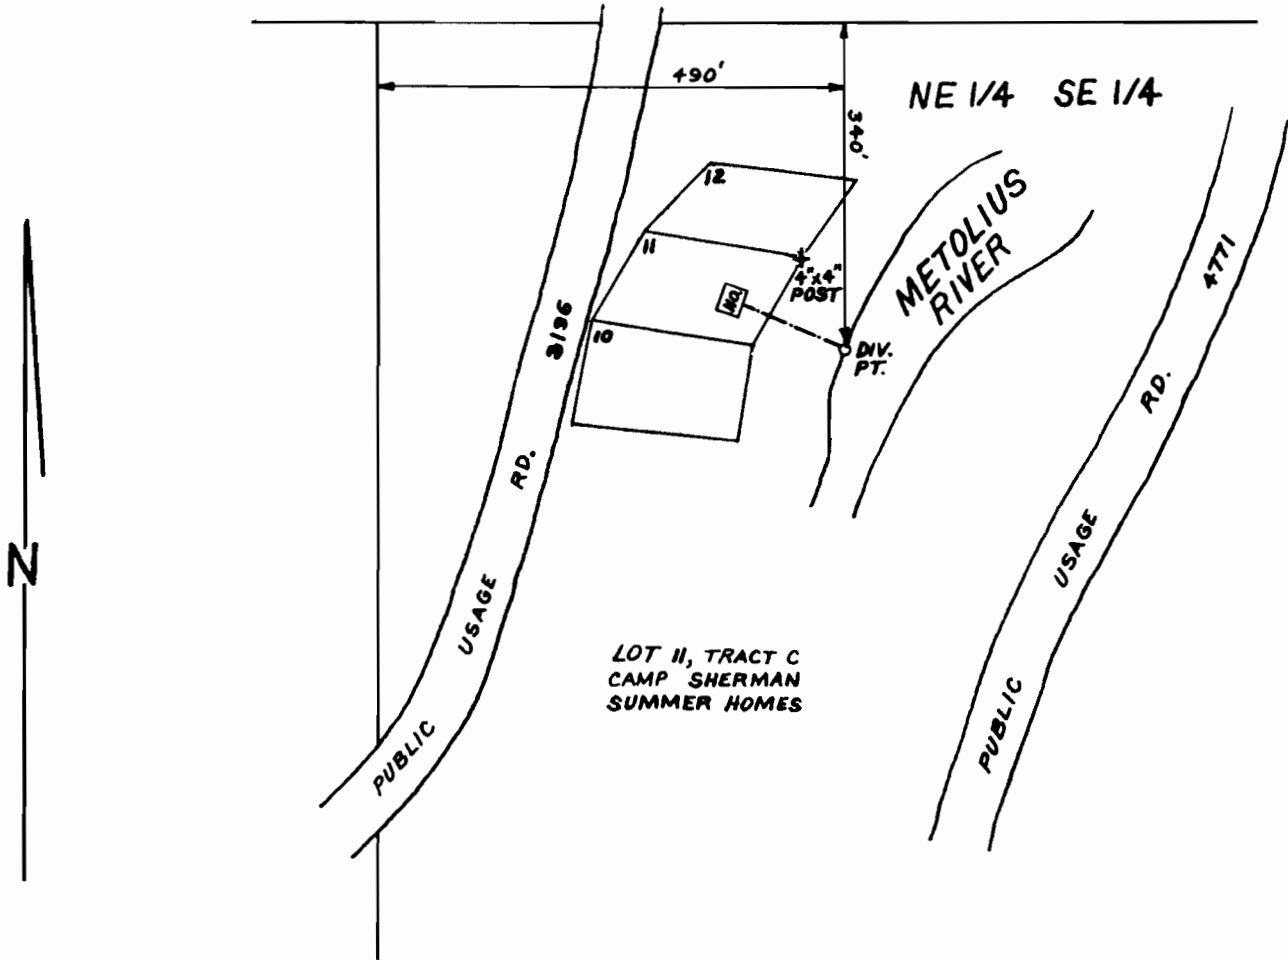

SCALE: 1" = 200'

FINAL PROOF SURVEY

UNDER

Application No. ~~65468~~ Permit No. ~~47956~~

IN NAME OF

GORDON HAYNES

Surveyed APRIL 3 19 85, by LESLIE OLSON