



T. 9 S. R. 38 & 39 E. W.M.

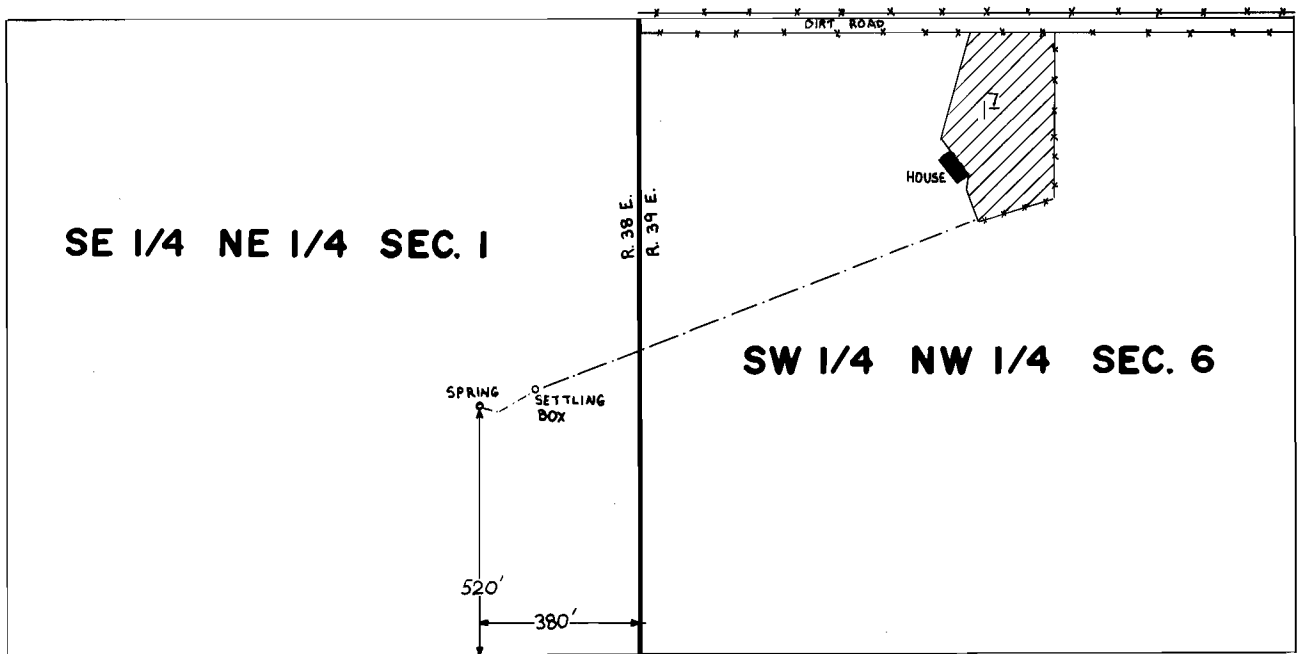

Scale 1" = 400'

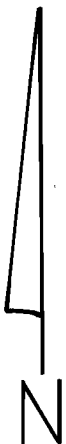

**FINAL PROOF SURVEY**  
UNDER

Application No. ~~68697~~ Permit No. ~~49696~~.....  
IN NAME OF

*RICHARD A. & KIM L. SMITH*

Surveyed April 16, 1987, by V. Church.....