


T. 1 S., R. 3 W., W. M. Sec. 33

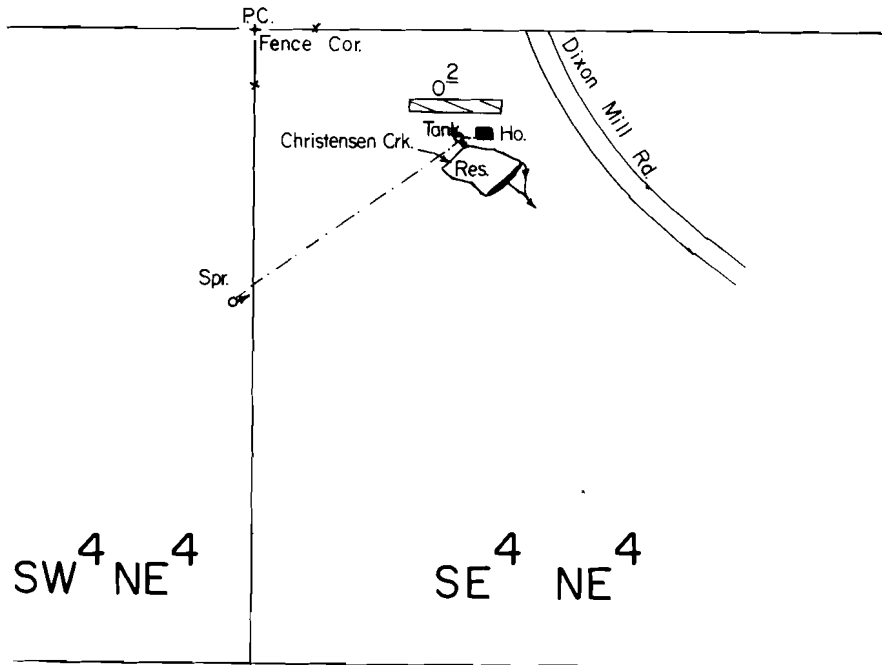

Spring Loc. : 570' S. & 40' W.
 P.O.D. Loc. : 310' S. & 510' E.
 both from NW Cor. SE⁴ NE⁴ Sec. 33.

Scale : 1" = 400'

FINAL PROOF SURVEY UNDER

R-58415 R-7826
 Application No. ~~58416~~ Permit No. ~~44145~~.....
 IN NAME OF

KARL KROPP

Surveyed AUG 5 & 7 1986, by BEN BISHOP.....
 & JULY 11 1988, by T. WARREN