


# T. 1 S., R. 3 W., W. M. Sec. 33

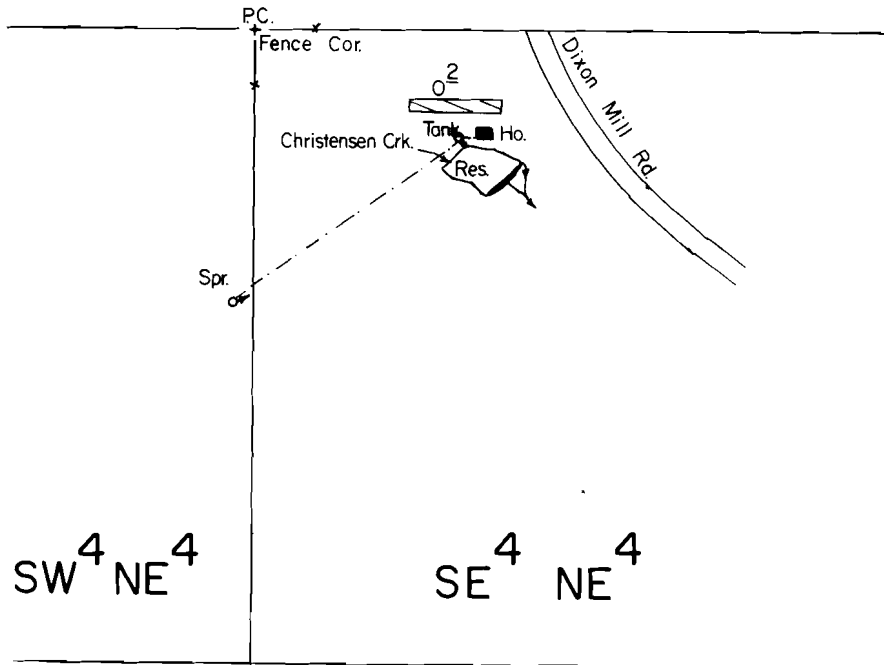

Spring Loc. : 570' S. & 40' W.  
 P.O.D. Loc. : 310' S. & 510' E.  
 both from NW Cor. SE<sup>4</sup> NE<sup>4</sup> Sec. 33.

Scale : 1" = 400'

## FINAL PROOF SURVEY UNDER

R-58415                      R-7826  
 Application No. ~~58416~~ Permit No. ~~44145~~.....  
 IN NAME OF

**KARL KROPP**

Surveyed AUG 5 & 7 1986, by BEN BISHOP.....  
 & JULY 11 1988, by T. WARREN