


T. 4N., R. 2W., W. M.

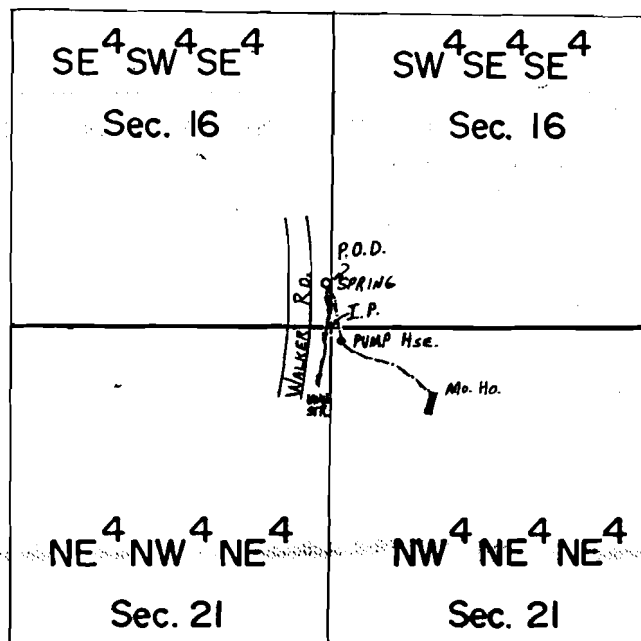

P.O.D. Loc.: 95' N. & 10' W. from SW Cor. SE⁴ SE⁴ Sec. 16.

Scale: 1" = 400'

FINAL PROOF SURVEY UNDER

Application No. ~~52369~~ Permit No. ~~46519~~.....
IN NAME OF

DAVID MARANVILLE

Surveyed JUNE 4, 1986, by T. Warren.....