


# T. 3 S., R. 2 E., W. M.

## Sec. 26

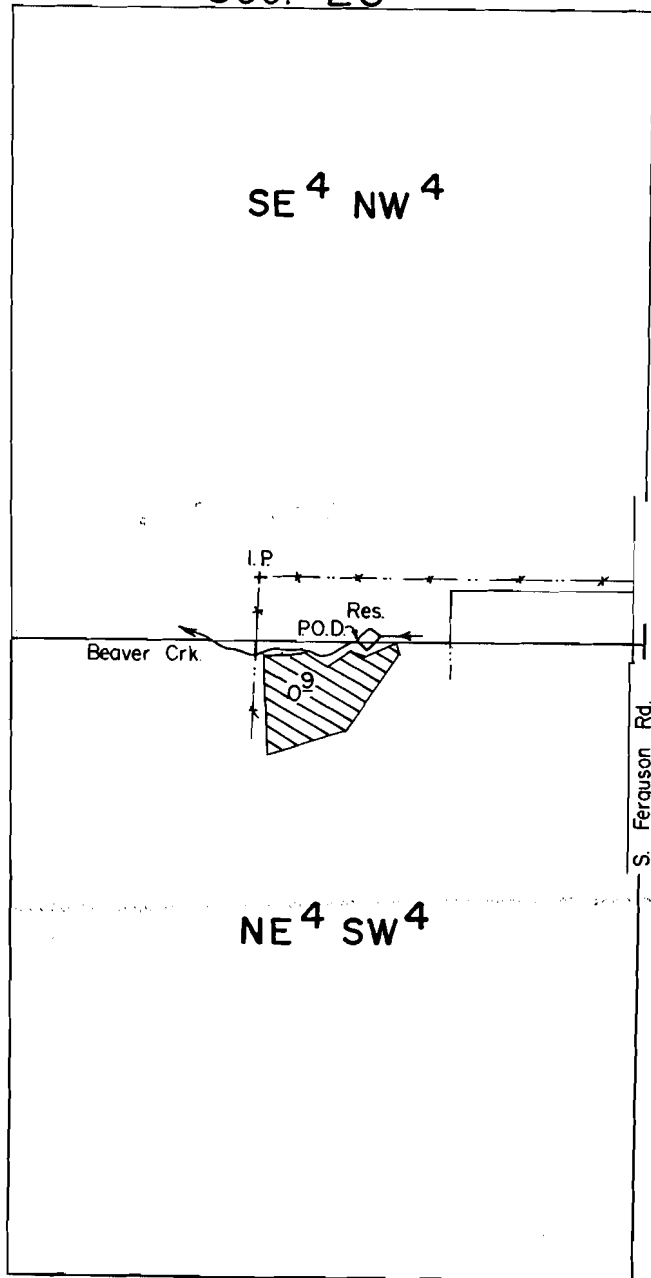

Scale: 1" = 400'



P.O.D. Loc. : 600' W from C. 1/4 Cor., Sec. 26.

### FINAL PROOF SURVEY

UNDER

R-63588

R-8439

Application No. ~~63589~~ Permit No. ~~46758~~.....

IN NAME OF

STEVEN WALTER JOHNSON

Surveyed AUG. 25. 1986., by T. Warren.....

PTS-1986-C  
TMW 2/11/87