

AUG 16 1982

WATER RESOURCES
SALEM, OREGON

SPECIAL USE PERMITS
Water Transmission
Cooperative Water
System for residences-
Brown, ~~Deason~~, & English &
Windus 10-15-63

Application No. 63848
Permit No. 47451

2

ELK
LAKE

APPROVED: MAR 5 1964

DATE

By *William D. Shank*
ACTING FOREST SUPERVISOR

3

PUMP

INTAKE

RECEIVED

FEB 9 1983

WATER RESOURCES DEPT.
SALEM, OREGON

ELK LAKE RECREATION
UNIT

Portion of Tract E

Lot 2 W.R. Brown

Lot 4 ~~L. Deason~~ English

Lot 5 L. Windus

J. Reatch

LEGEND


— Pipeline

⋈ Valve

SCALE 1" = 50' FEB 15 1963

C 64841

47451

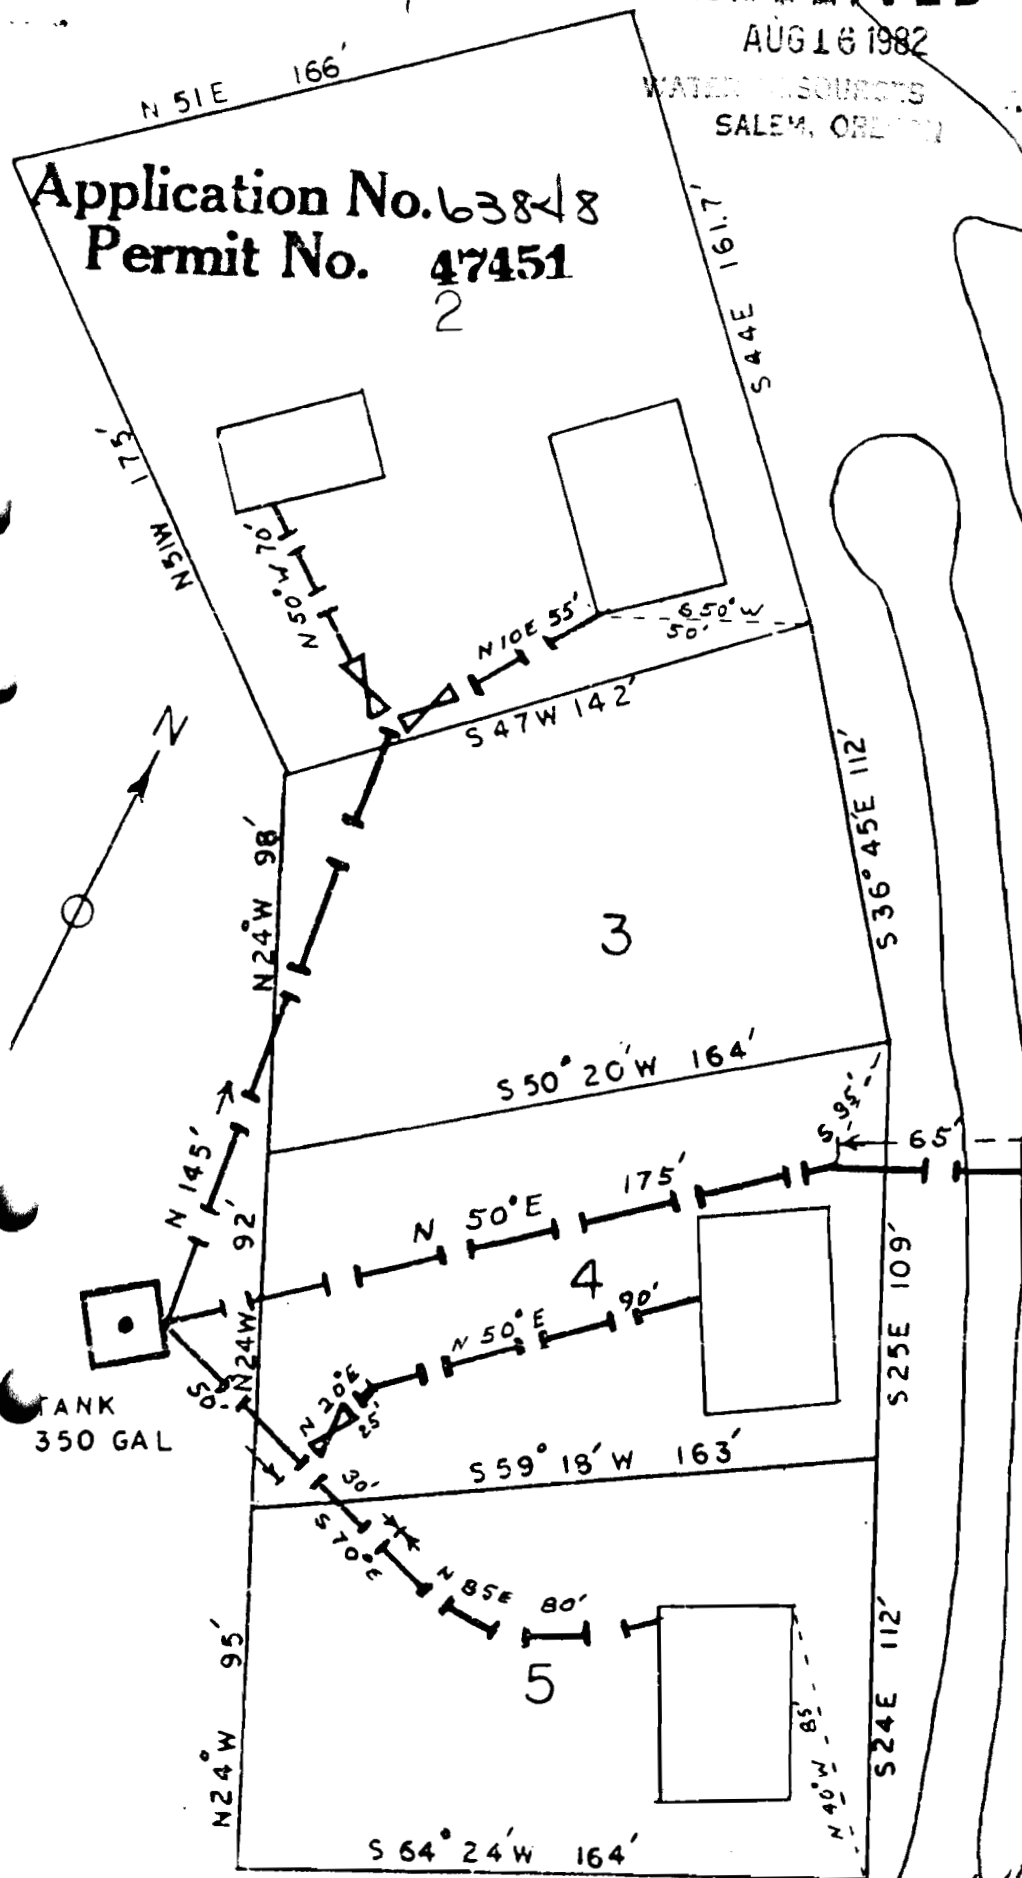

Field Work and Mapping By: *W.D. Shank*

See Map 18 in


AUG 16 1982

WATER RESOURCES
SALEM, OREGON

Sec 32 Twp 18S Rge 8E
1" = 200'

~~Application No. 63848~~

Permit No. 47451

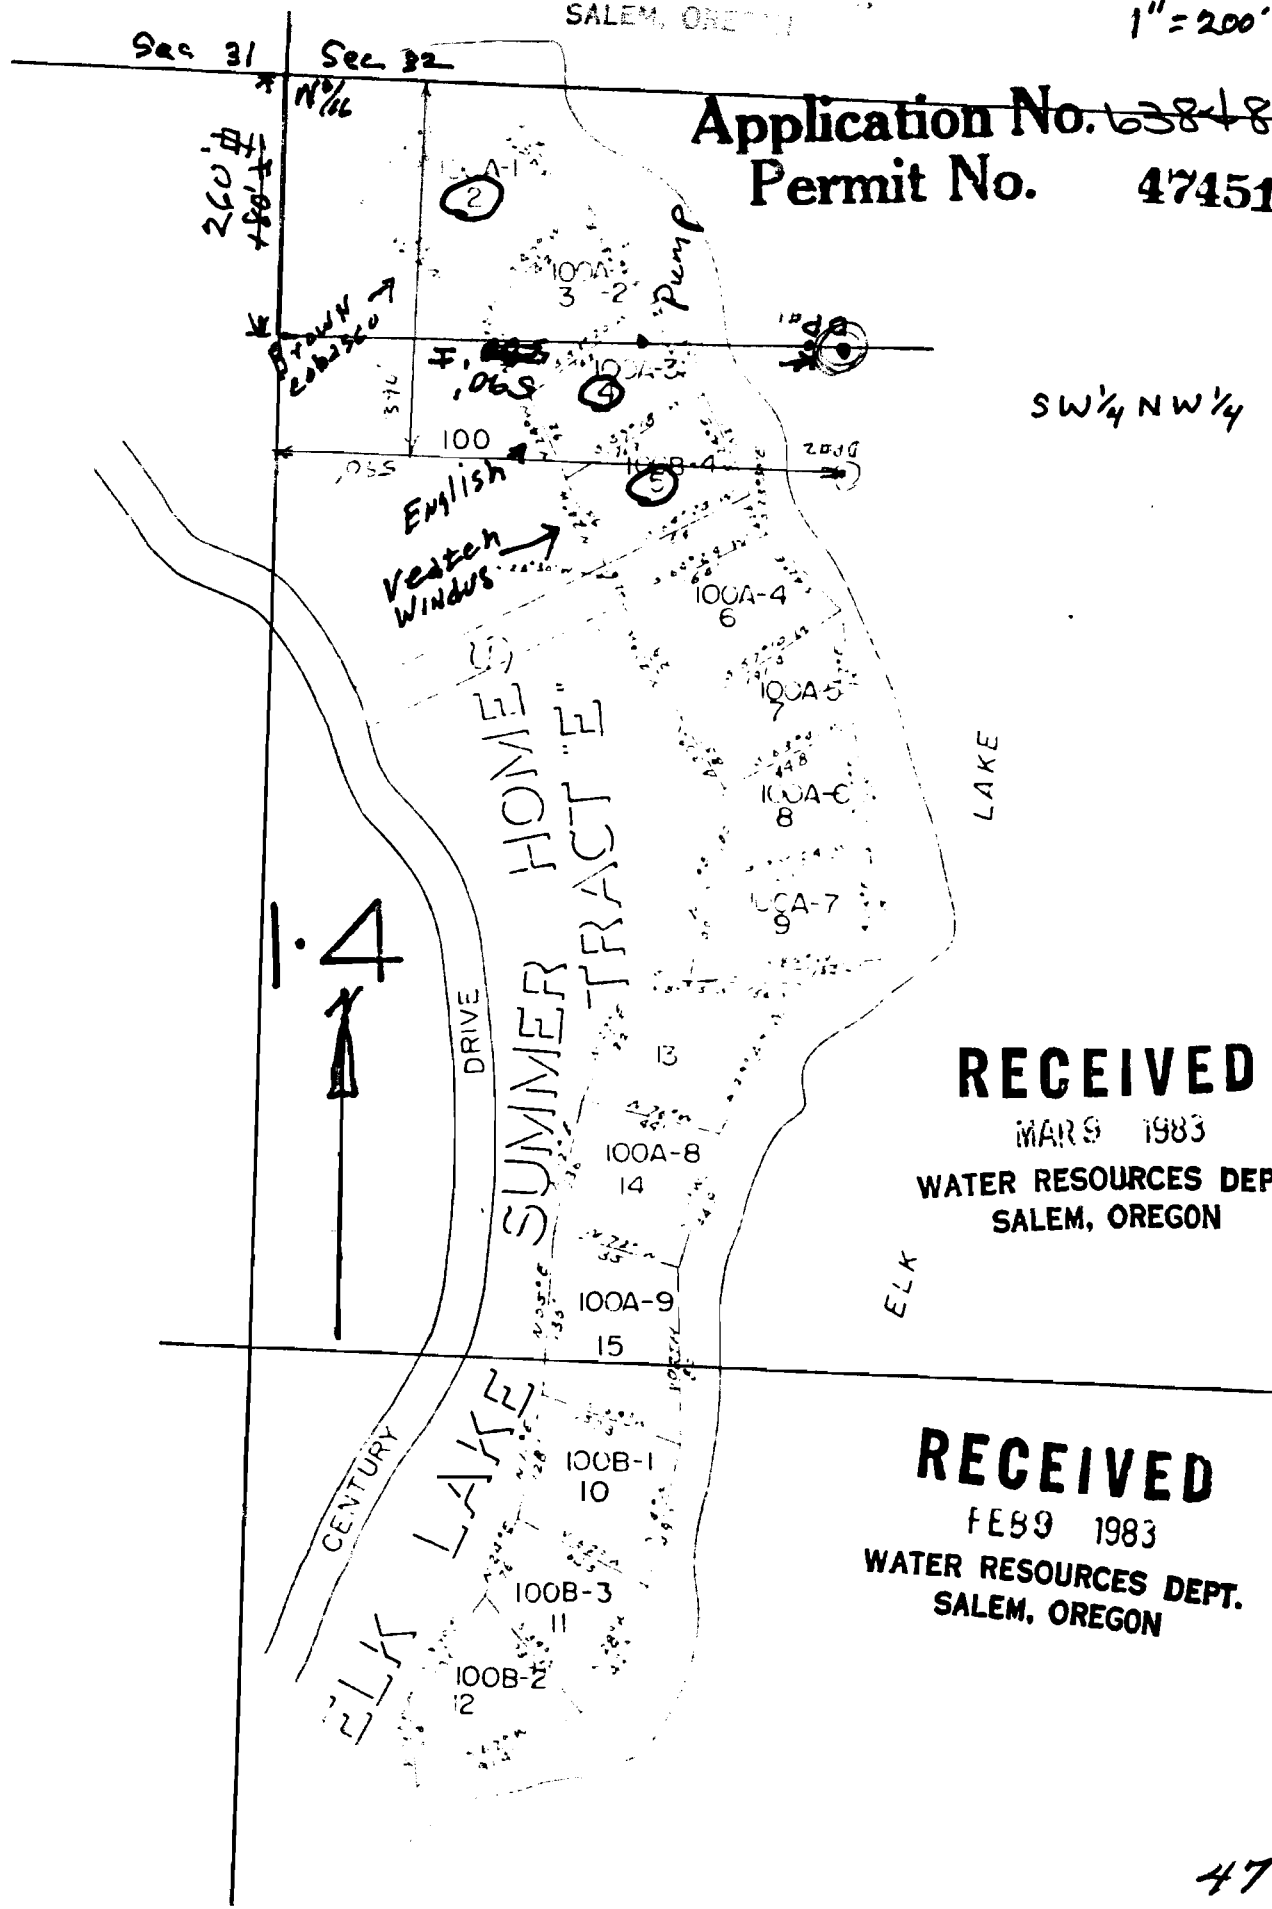

RECEIVED

MAR 9 1983

**WATER RESOURCES DEPT.
SALEM, OREGON**

RECEIVED

FEB 9 1983

WATER RESOURCES DEPT.
SALEM, OREGON

#2

47451