
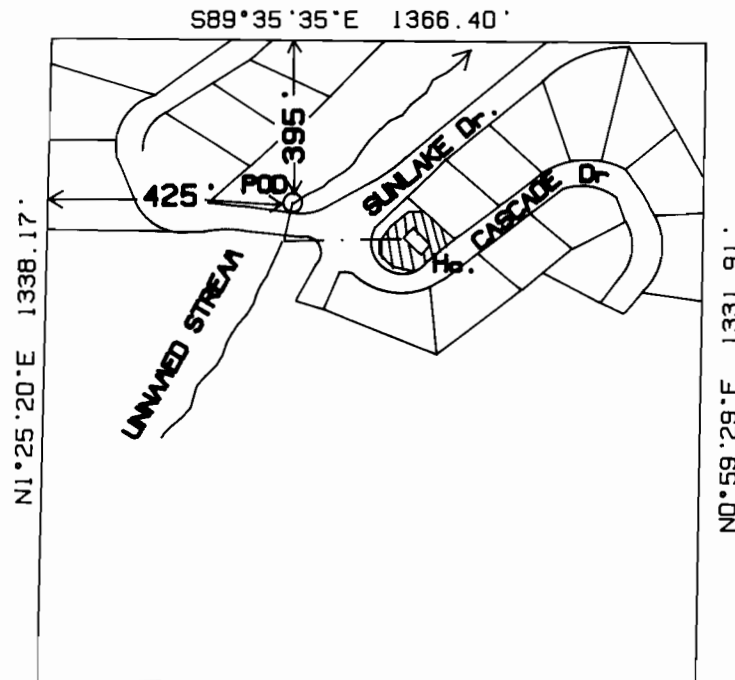


T.23S..R.12W..W.M.

SV COR OF THE SE1/4
OF THE NW1/4 OF SEC 10

CENTER 1/4 COR
SECTION 10

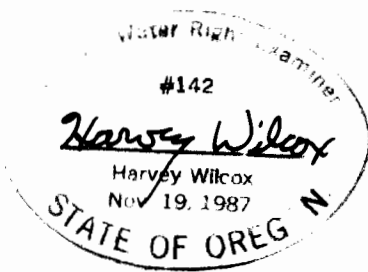

BASIS OF BEARINGS IS
FROM SURVEY 1-B-31

SCALE 1" = 400'

FINAL PROOF SURVEY

Application No. ~~89282~~.... Permit No. ~~50200~~.....

IN NAME OF

.....GLEN L. MEYER.....

Surveyed AUG., 8, 1989.. by H.A. WILCOX