

NO. 1

N 66° 51' 15" W

CHAIN LINK FENCE

- - FOUND 1/2" IRON PIN
- ⊙ - FOUND 5/8" IRON PIN

I do hereby certify that an actual field survey was made of the subject property on April 14, 1976 and that all overlaps and encroachments (north fence) are as shown on the annexed map.

Joseph S. Westvold
 Joseph S. Westvold
 Professional Engineer
 Oregon Registration No. 6115

WESTVOLD & ASSOCIATES

ENGINEERING SURVEYING

KLAMATH FALLS, OREGON

DESIGNED FOR MAYWOOD INDUSTRIES OF OREGON

DESIGNED BY	E.R.R.	4 - 76
BY	S.L.B.	4 - 76
BY	J.S.W.	4 - 76

Suburban Water Co. Lake

SCALE 1" = 100'

Suburban Water Co.
 ← Drainage Ditch to C

Col

06' 43" W

973.79

CHAIN LINK FENCE

100.0'

172.4'



CHAIN LINK FENCE

270.00

973.79

S 66° 51' 15" E

FENCE ENCROACHMENT

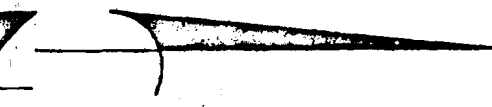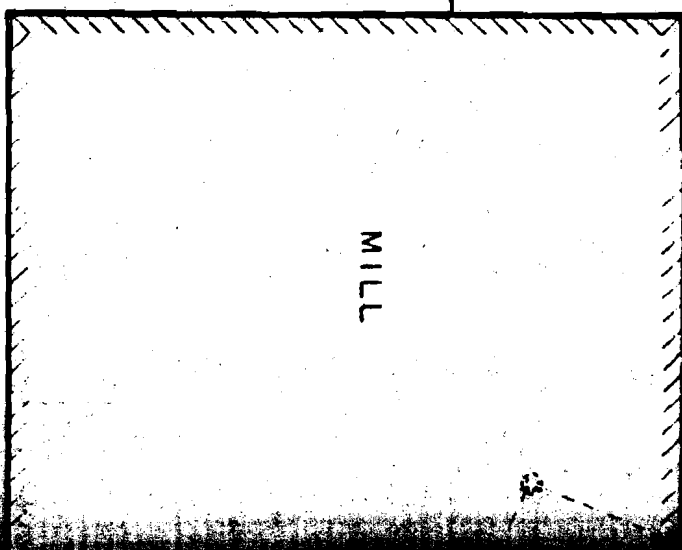

000

A.L.T.A. SURVEY

SITUATED IN THE E1/2 OF SECTION 4, T39S, R9EWM.
KLAMATH COUNTY, OREGON
INCLUDING A PORTION OF LOT 2, BLOCK 2, TRACT 1080

OC 8 E

RAILROAD

WATER SUPPLY BOX
AND FIRE HYDRANT


EDGE C. 60' INSIDE LINE
R/R 35-4

150.7'

FENCE 1.1' WEST OF LINE

10.6'

WELL

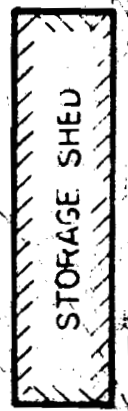

SAWDUST
BIN
150.



3'

N 35 32 01 W

3

2

WAY

WASHBURN

BLK. 2

2

BLK. 3

960.96

1/4
4 7

S 34° 47' 00" W
NORTH 1/4 SE 1/4

144'
N 2° 30' 00" E
NE 1/4 SE 1/4

Application No. ~~G-7478~~ G-7536
Permit No. ~~G-6826~~ G 7008

Existing Drainage Dish

CROSBY AVE.

G-700

WEST LINE OF
30' SEWER LGMT.

UNDERGROUND TELEPHONE CABLE

CHAIN LINK FENCE

EASEMENT

Shurhan