




T.31S., R.4W., W.M.
SECTION 33

SCALE: 1" = 400'

-  Primary & Supplemental Irrigation
-  Supplemental Irrigation

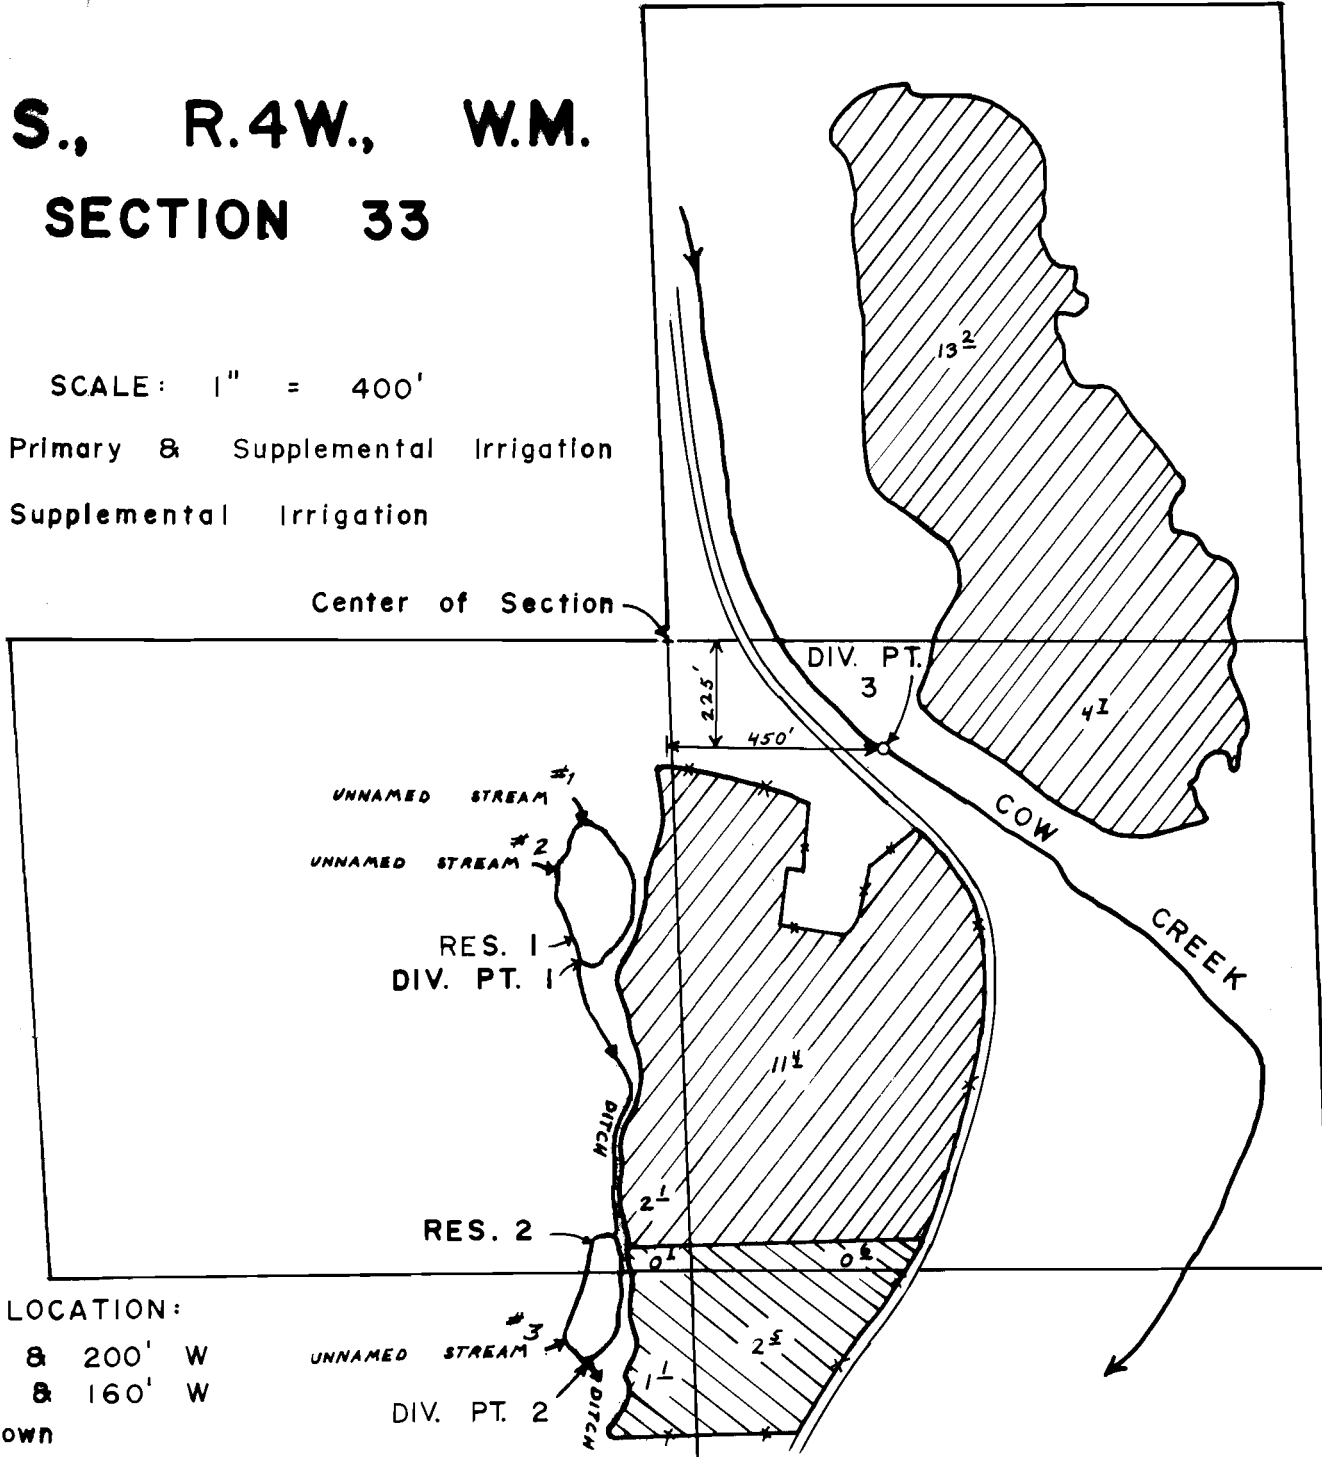

DIV. PT. LOCATION:

- 1) 670' S & 200' W
- 2) 1500' S & 160' W
- 3) As shown

All from the center of
 Sec. 33

FINAL PROOF SURVEY
 UNDER

R- 56899 R- 7255
 Application No. ~~56900~~ Permit No. ~~43055~~.....
 IN NAME OF

THOMAS C. & SUSAN M. SMITH, JR.

Surveyed O.C.T. 6, 1983, by *J. E. Cashman*