


T. 25 S., R. 6 W., W.M.

SECTION 1

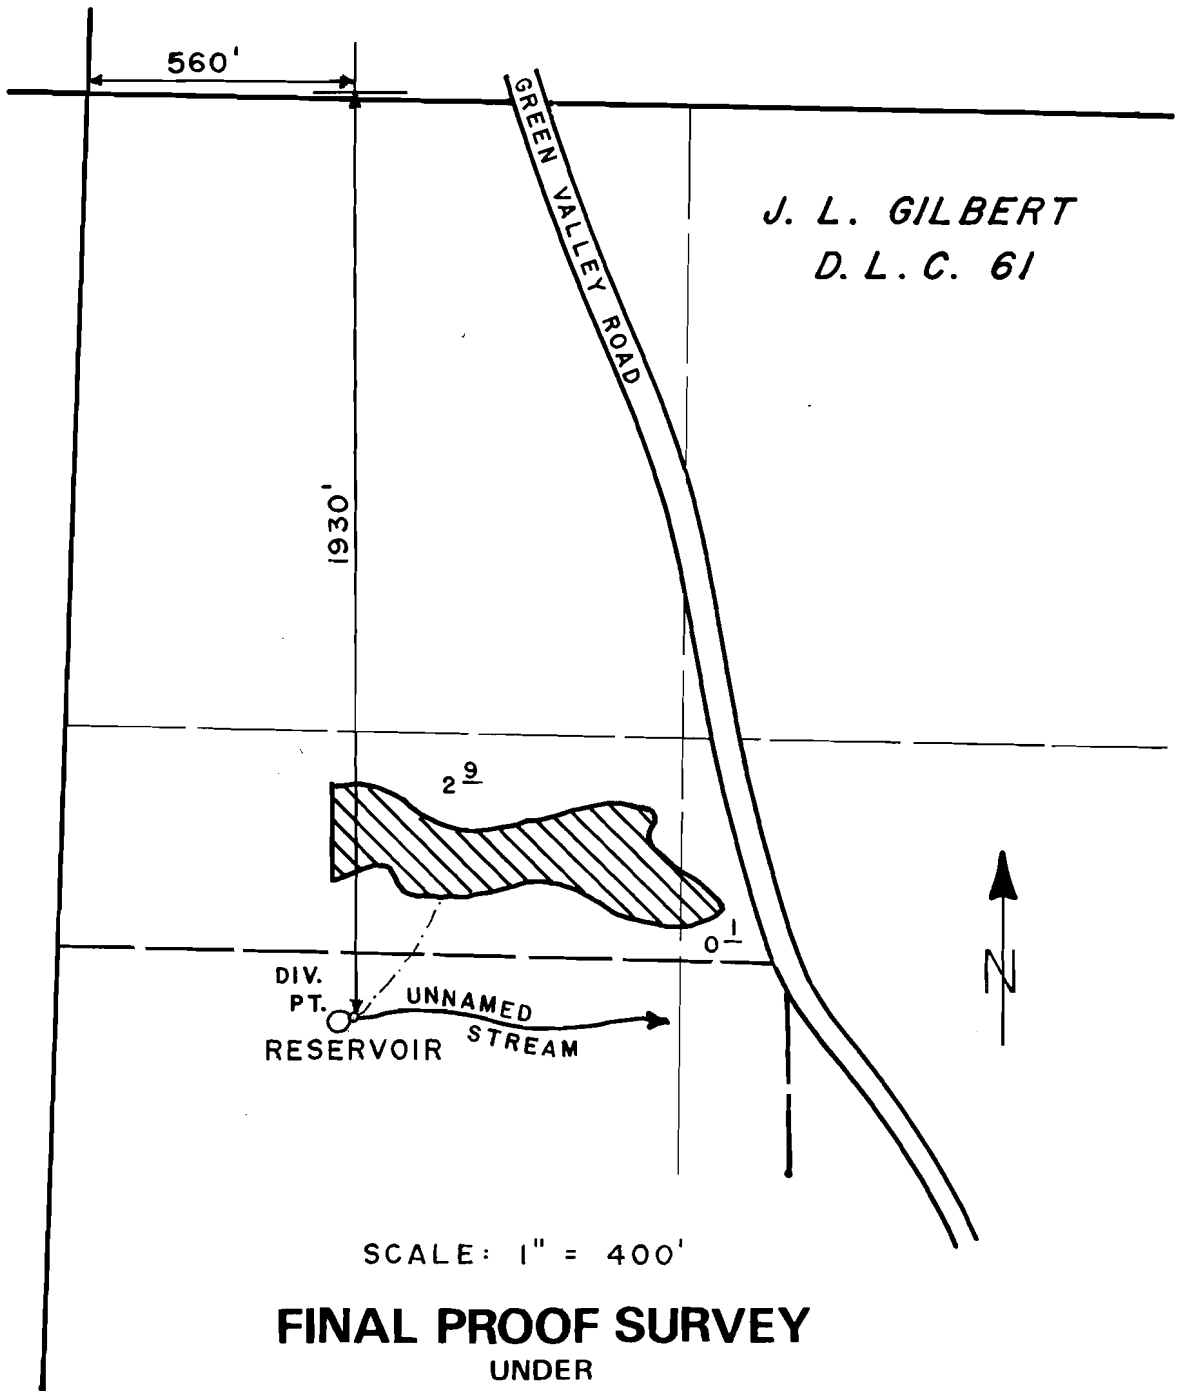

SCALE: 1" = 400'

FINAL PROOF SURVEY
UNDER

R-65596 R-8991
Application No. ~~65597~~ Permit No. ~~48004~~
IN NAME OF

LOREN R. BARNETT

Surveyed JULY 14 1986, by J. M. SCHMORDE
SEPT. 19, 1991, B. S. JAMES