

44050  
02044  
67743

1" = 100'


Application No. 58433  
Permit No. 44050



**RECEIVED**

MAR 21 1979  
WATER RESOURCES DEPT.  
SALEM, OREGON

Spring LOCATED  
455 ~~420~~ FT SOUTH  
1530 ~~1523~~ FT WEST OF  
N 1/4 COR SEC 14

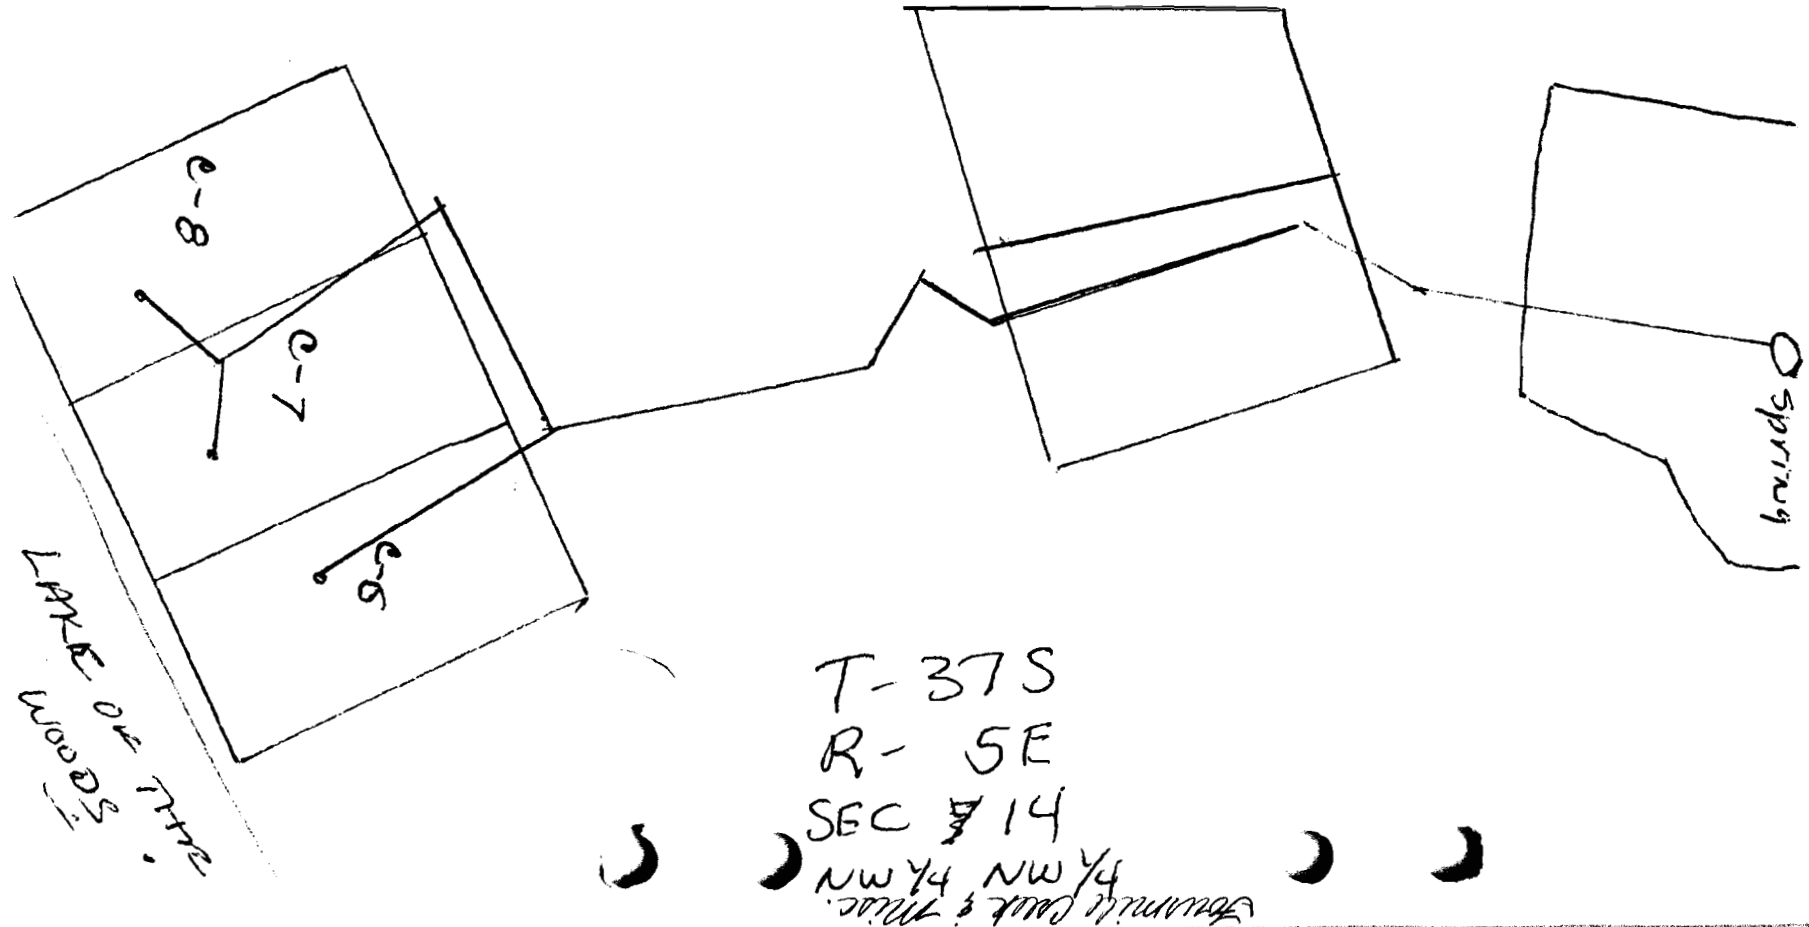

LAKE OF THE  
WOODS

T-37S  
R-5E  
SEC 14

NW 1/4 NW 1/4  
STANLEY GALT & MISC.  
P/MN P/MN