


APPLICATION MAP FOR PERMIT TO CONSTRUCT A RESERVOIR

SE1/4 SW1/4 SEC 19 T 18S R 40E W.M.
U.S.G.S. QUAD - LITTLE BLACK CANYON, OREG. - 7 1/2'



RECEIVED

SEP 23 1993

WATER RESOURCES DEPT.
SALEM, OREGON

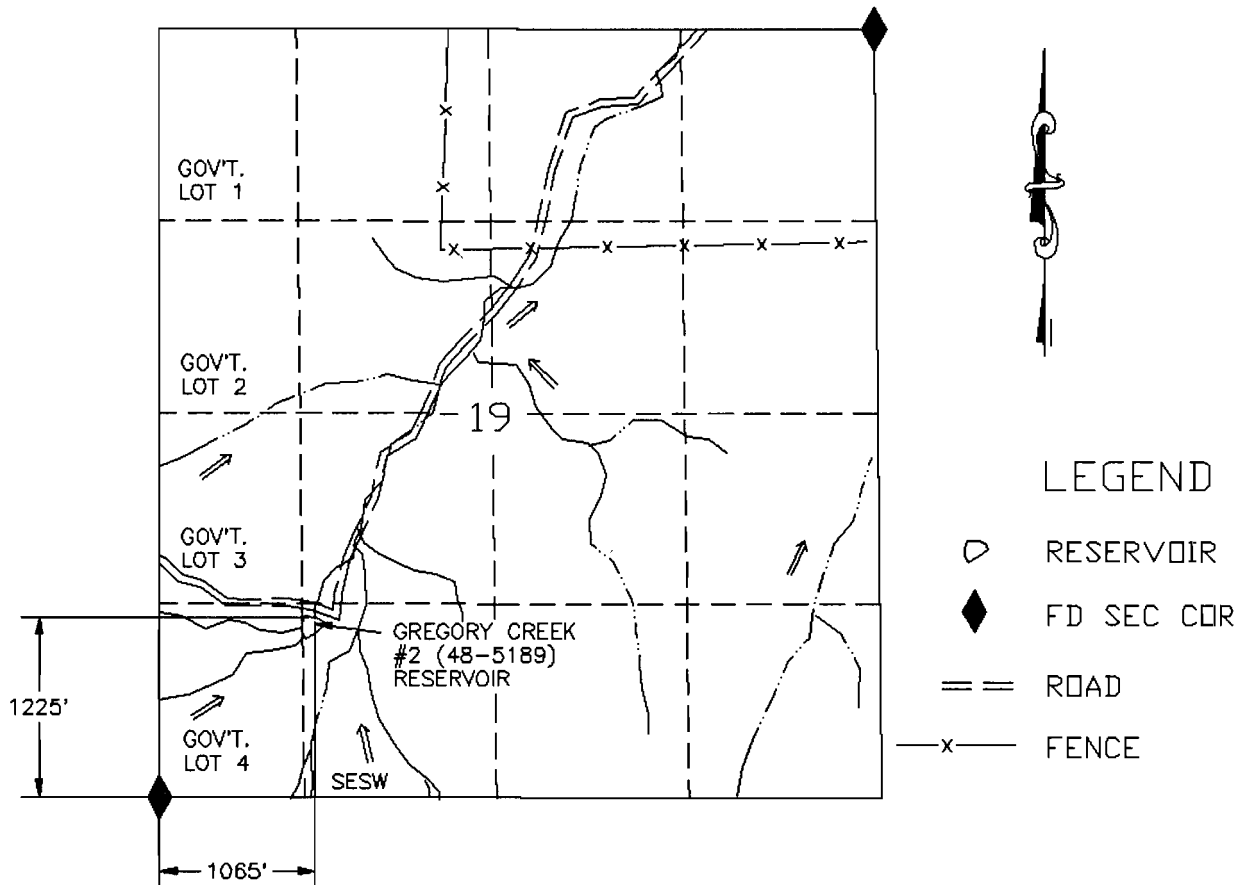

GREGORY CREEK #2 (48-5189) RESERVOIR

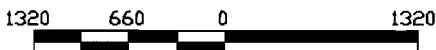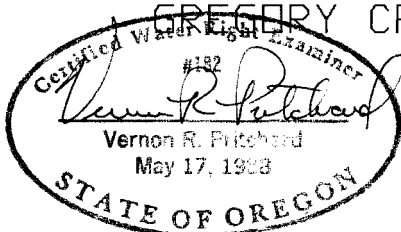

SCALE 1"=1320'

THIS MAP IS FOR THE PURPOSE OF LOCATING
A WATER RIGHT AND IS NOT INTENDED TO
PROVIDE LEGAL DIMENSIONS FOR LOCATION
OF PROPERTY BOUNDARIES.



ACAD RELEASE 11/DCA
DWG FILE: GREGCR2A.DWG

UNITED STATES DEPARTMENT OF THE INTERIOR BUREAU OF LAND MANAGEMENT DIVISION OF OPERATIONS VALE DISTRICT	
GREGORY CREEK #2 (48-5189) RESERVOIR	
DESIGNED	
REVIEWED	<i>Vernon R. Pritchard</i>
APPROVED	<i>George House</i> CHIEF, BRANCH OF ENGINEERING
DRAWN: CG	SCALE: 1"=1320'
DATE: 09/04/93	SHEET 1 OF 1
DRAWING NO. OR-03-9172.45-392	

Application No. R-73625

Permit No.

CERTIFICATE NO.



68952

AS BUILT MAP OF GREGORY CREEK (48-5189) #2 RESERVOIR

LEGEND

— 88 — CONTOUR & ELEV
 - - - - - HIGH WATER LINE
 ELEV. 89.50
 - - - - - CHANNEL
 ▲ MONUMENT

SE1/4 SW1/4, SEC 19, T. 18S., R. 40 E., W.M.
 U.S.G.S. QUAD - LITTLE BLACK CANYON, OREG. - 7 1/2'

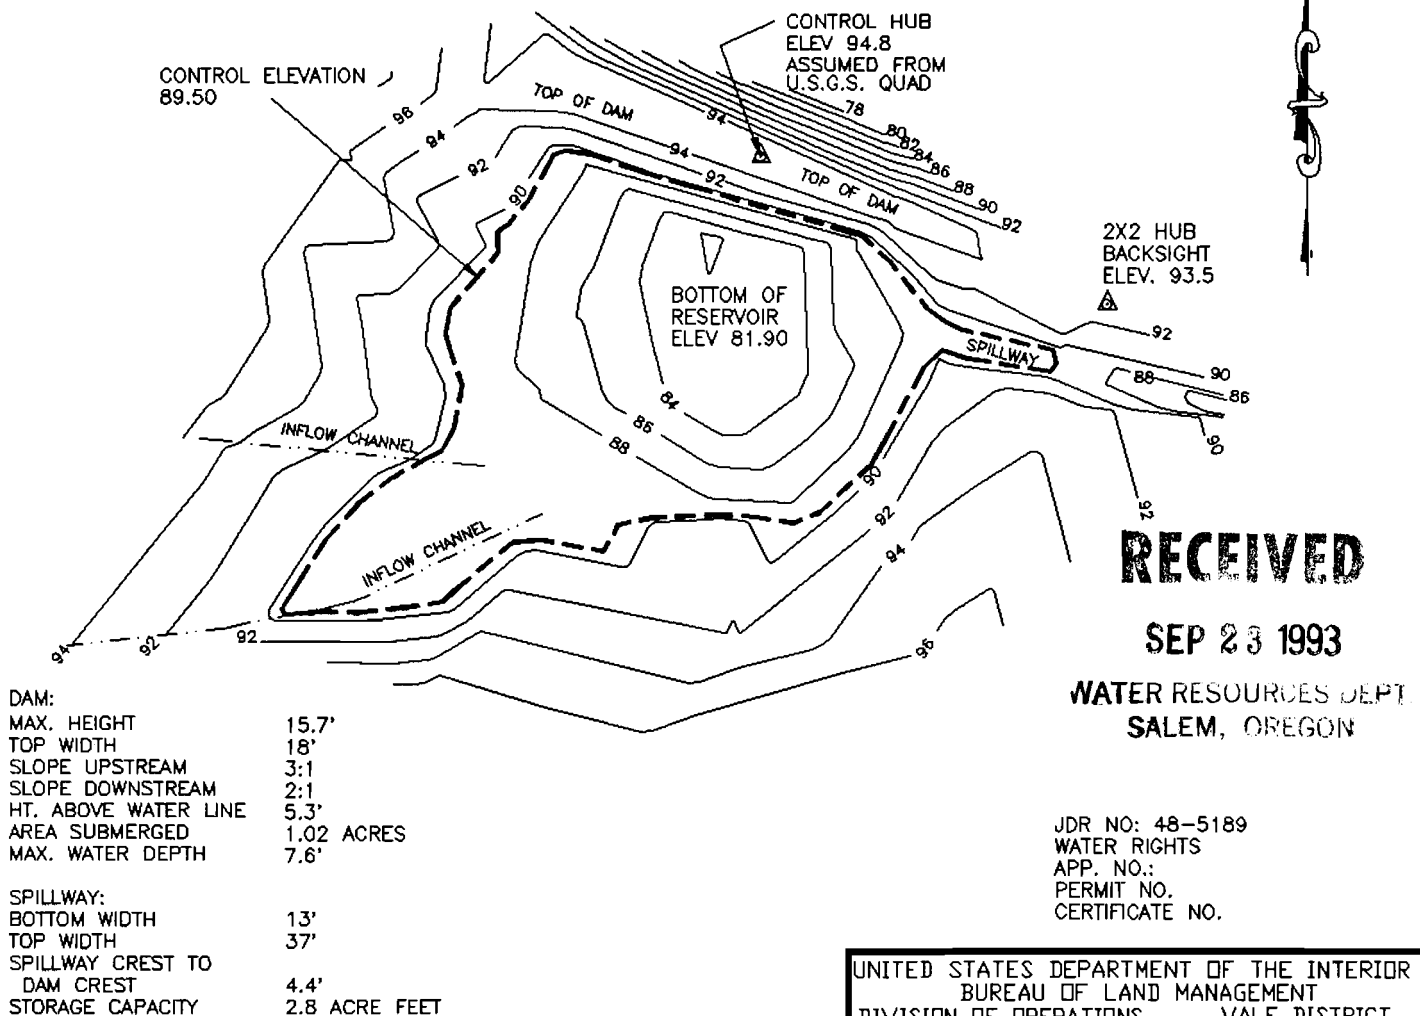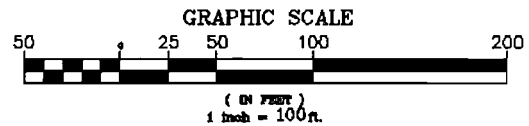

RECEIVED

SEP 23 1993

**WATER RESOURCES DEPT
 SALEM, OREGON**

JDR NO: 48-5189
 WATER RIGHTS
 APP. NO.:
 PERMIT NO.
 CERTIFICATE NO.

FAILURE OF THIS STRUCTURE WOULD NOT POSE A THREAT TO LIFE OR PROPERTY. INSTALLATION OF AN OUTLET CONDUIT WOULD THREATEN THE INTEGRITY OF THE EXISTING STRUCTURE. SHOULD AN OUTLET CONDUIT BE REQUIRED LATER FOR WATER DISTRIBUTION NEEDS, IT WILL BE INSTALLED USING APPROPRIATE SAFEGUARDS AND CONSTRUCTION TECHNIQUES, OR THE STRUCTURE MAY BE BREACHED OR RE-CONSTRUCTED.



ACAD 11/DCA
 GREGCR2.DWG

UNITED STATES DEPARTMENT OF THE INTERIOR
 BUREAU OF LAND MANAGEMENT
 DIVISION OF OPERATIONS VALE DISTRICT

**GREGORY CREEK (48-5189) #2
 RESERVOIR AS BUILT**

DESIGNED FIELD SURVEY
 REVIEWED *Wynne R. Pulghaus*
 APPROVED *George D. House*
 CHIEF, BRANCH OF ENGINEERING

DRAWN: C.G. SCALE: 1"=100
 DATE: 12/28/92 SHEET 1 OF 1
 DRAWING NO. OR-03-9172.45-163

Project No. R-73625
 Permit No.
 Certificate No. 13952