

APPLICATION MAP FOR PERMIT TO CONSTRUCT A RESERVOIR


NW1/4NE1/4SEC 4 T 41S R 39E W.M.

U.S.G.S. QUAD - CHICKEN SPRING, OREG. - 7 1/2'


RECEIVED

SEP 24 1993

WATER RESOURCES DEPT.
SALEM, OREGON

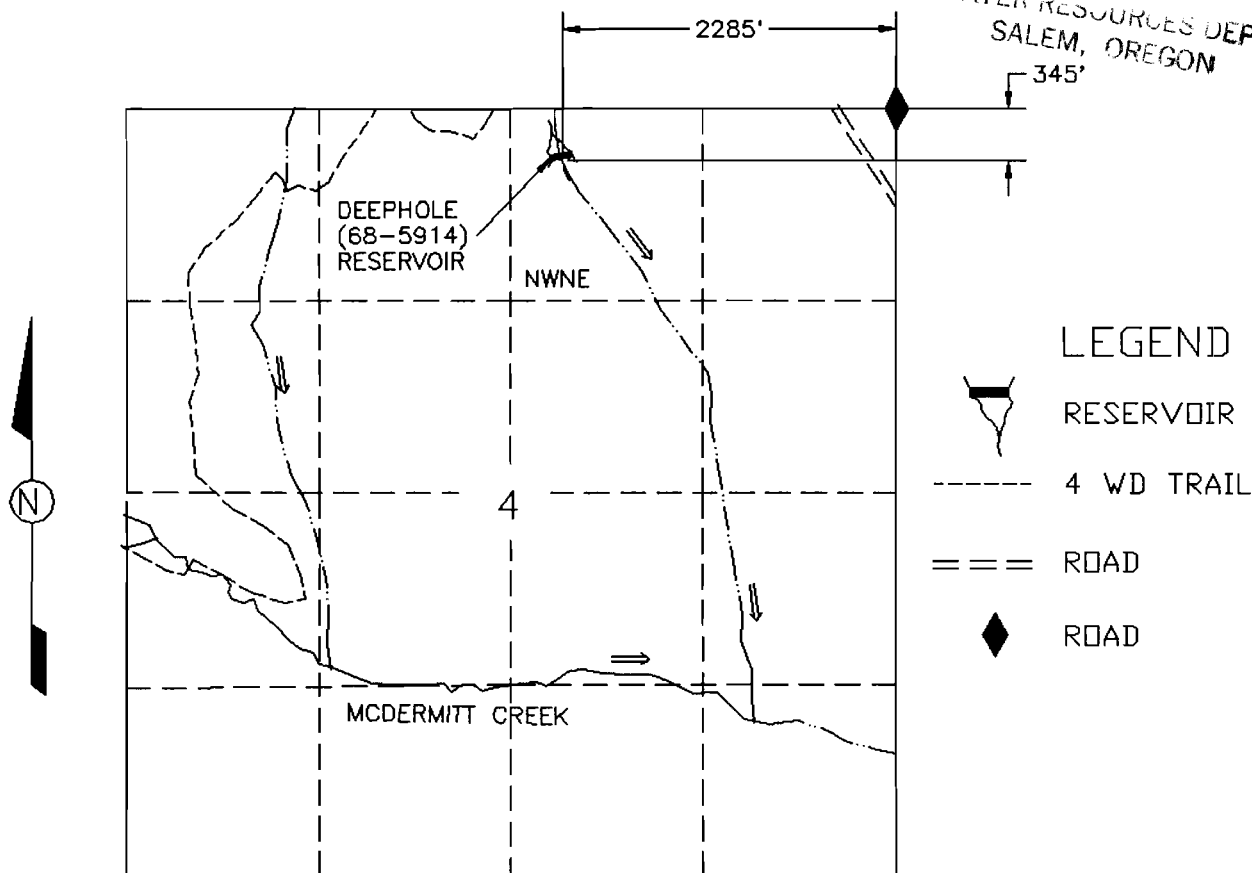

DEEPHOLE (68-5914) RESERVOIR

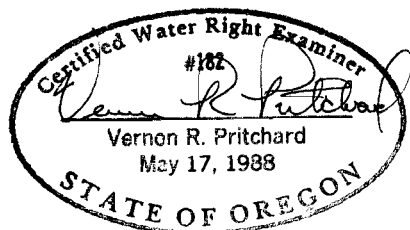

1320 660 0 1320

SCALE 1"=1320'

THIS MAP IS FOR THE PURPOSE OF LOCATING
A WATER RIGHT AND IS NOT INTENDED TO
PROVIDE LEGAL DIMENSIONS FOR LOCATION
OF PROPERTY BOUNDARIES.



UNITED STATES DEPARTMENT OF THE INTERIOR
BUREAU OF LAND MANAGEMENT
DIVISION OF OPERATIONS VALE DISTRICT

DEEPHOLE (68-5914) RESERVOIR

DESIGNED
REVIEWED
APPROVED

DRAWN: CG SCALE: 1"=1320'

DATE: 08/23/93 SHEET 1 OF 1

DRAWING NO. OR-03-9172.45-357

ACAD RELEASE 11/DCA
DWG FILE:DEEPHAPP.DWG

R-73644
68970
"CERTIFICATE NO. _____"

LEGEND

U.S.G.S. QUAD -CHICKEN SPRING, OREG.- 7 1/2'

- GRAPHIC SCALE**
- 50 25 50 100 200
- 
- (IN FEET)
1 inch = 100 ft.

RECEIVED

SEP 24 1993

§

SPILLWAY:	
BOTTOM WIDTH	9.0'
TOP WIDTH	39.0'
SPILLWAY CREST TO DAM CREST	4.0'
STORAGE CAPACITY	2.58 ACRE FEET

JDR NO: 68-5914
WATER RIGHTS
APP. NO.:
PERMIT NO.
CERTIFICATE NO.

DEEPHOLE (68-5914)
RESERVOIR AS BUILT

APPROVED *James D. [Signature]*

CHIEF BRANCH OF ENGINEERING

DATE: 08/26/92	SHEET 1 OF 1
----------------	--------------

DRAWING NO. OR-03-9172.45-117



ACAD 11/DCA
DEEPHOLE.DWG

* CERTIFICATE NO

03970