

APPLICATION MAP FOR PERMIT TO CONSTRUCT A RESERVOIR



GOV'T. LOT 3 SEC 19 T 10S R 42E W.M.

U.S.G.S. QUAD - OXMAN & ENCINA, OREG. - 7 1/2'

RECEIVED
SEP 30 1993
WATER RESOURCES DEPT
SALEM, OREGON

LEGEND

-  RESERVOIR
-  ROAD
-  TRAIL
-  CREEK
-  POWER LINE
-  GRAVEL PITS

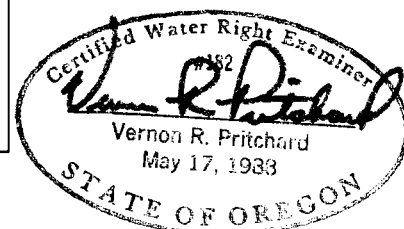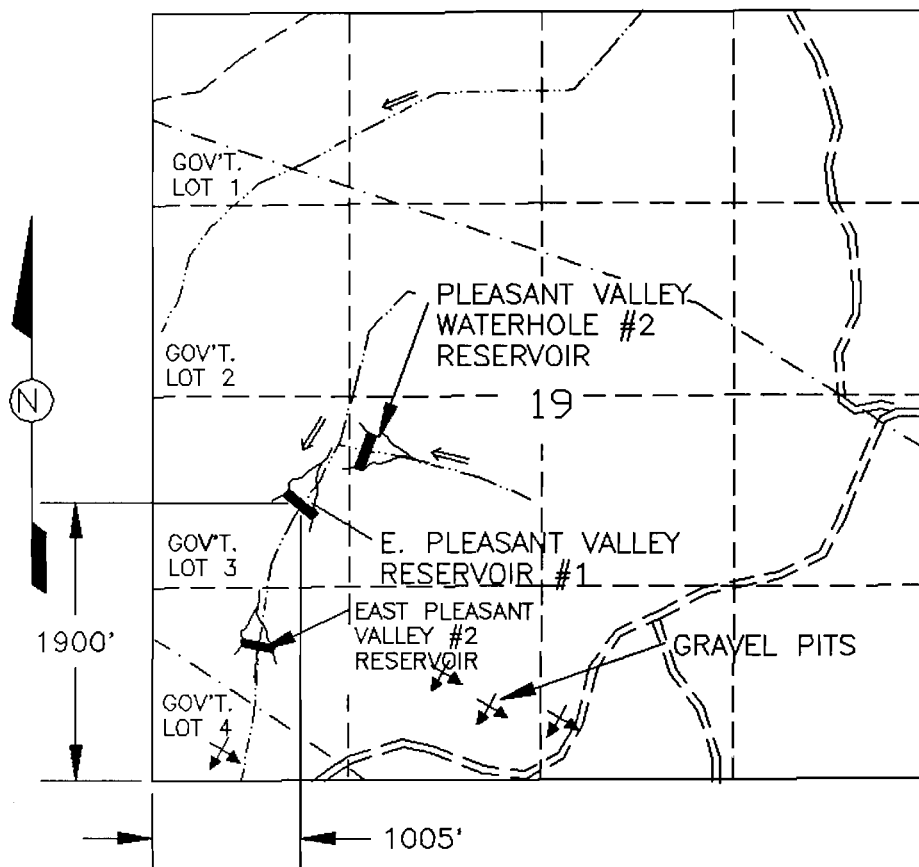

EAST PLEASANT VALLEY RESERVOIR #1



SCALE 1"=1320'

THIS MAP IS FOR THE PURPOSE OF LOCATING
A WATER RIGHT AND IS NOT INTENDED TO
PROVIDE LEGAL DIMENSIONS FOR LOCATION
OF PROPERTY BOUNDARIES.



ACAD RELEASE 11/DCR
DWG FILEPLSVALL1

UNITED STATES DEPARTMENT OF THE INTERIOR
BUREAU OF LAND MANAGEMENT
DIVISION OF OPERATIONS VALE DISTRICT

EAST PLEASANT VALLEY RESERVOIR #1

DESIGNED *Vernon R. Pritchard*
REVIEWED *George R. House*
APPROVED *George R. House*
CHIEF, BRANCH OF ENGINEERING

DRAWN: CG SCALE: 1"=1320'

DATE: 05/04/93 SHEET 1 OF 1

DRAWING NO. OR-03-9172.45-260

R-73660

02085

APPLICATION MAP FOR PERMIT TO CONSTRUCT A RESERVOIR


NE 1/4 SW 1/4 SEC 19 T 10S R 42E W.M.

U.S.G.S. QUAD - OXMAN & ENCINA, OREG. 7 1/2'


RECEIVED
SEP 30 1993
WATER RESOURCES DEPT.
SALEM, OREGON

LEGEND

-  RESERVOIR
-  ROAD
-  JEEP TRAIL
-  CREEK
-  POWER LINE
-  GRAVEL PITS

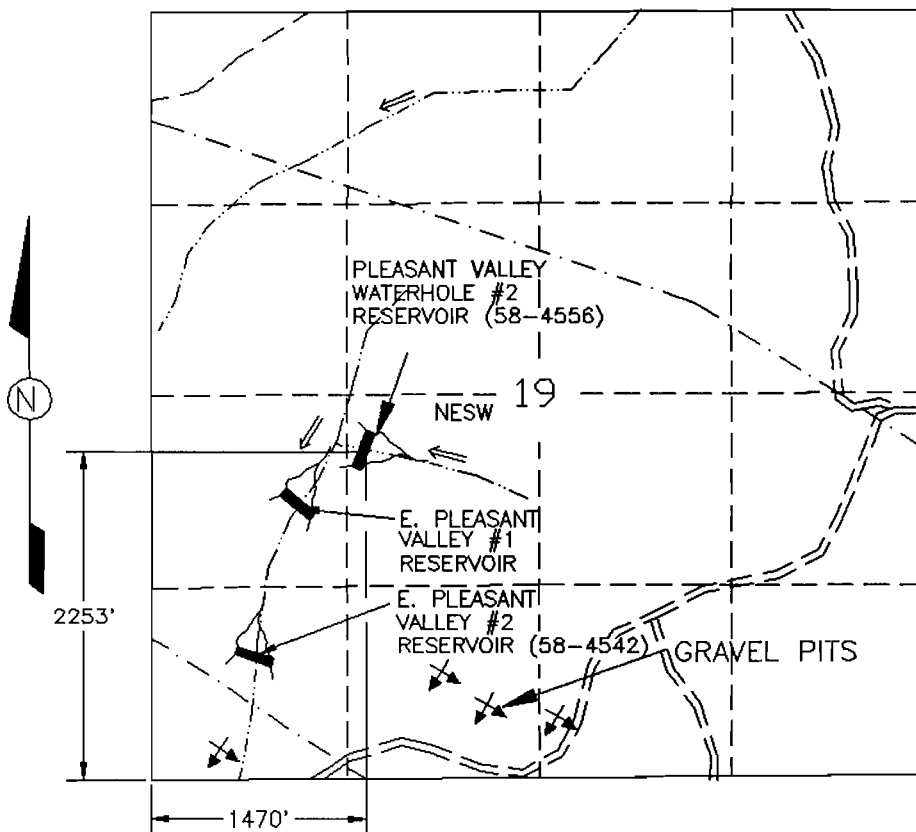


PLEASANT VALLEY WATERHOLE #2

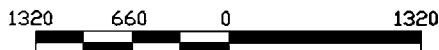

SCALE 1"=1320'

THIS MAP IS FOR THE PURPOSE OF LOCATING
A WATER RIGHT AND IS NOT INTENDED TO
PROVIDE LEGAL DIMENSIONS FOR LOCATION
OF PROPERTY BOUNDARIES.

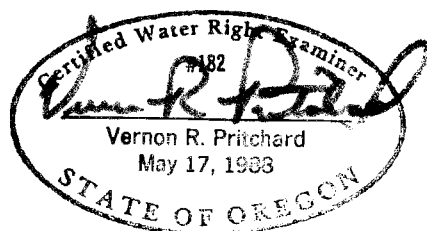

ACAD RELEASE 10
DWG FILEPLSAPP2

UNITED STATES DEPARTMENT OF THE INTERIOR BUREAU OF LAND MANAGEMENT DIVISION OF OPERATIONS VALE DISTRICT	
PLEASANT VALLEY WATER HOLE #2 (58-4556)	
DESIGNED <i>Vernon R. Pritchard</i>	
REVIEWED	
APPROVED <i>George D. House</i>	CHIEF, BRANCH OF ENGINEERING
DRAWN: CG	SCALE: 1"=1320'
DATE: 05/11/93	SHEET 1 OF 1
DRAWING NO. OR-03-9172.45-143	

R-73660

Permit No.



CERTIFICATE NO. 00085

AS BUILT MAP OF PLEASANT VALLEY WATERHOLE #2 (58-4556)

LEGEND

NE 1/4 SW 1/4 SEC 19, T. 10S., R. 42 E., W.M.
U.S.G.S. QUAD OXMAN, OREG. - 7 1/2'

- 88 ——— CONTOUR & ELEV
- HIGH WATER LINE
ELEV. 94.79
- CHANNEL
- ▲ MONUMENT

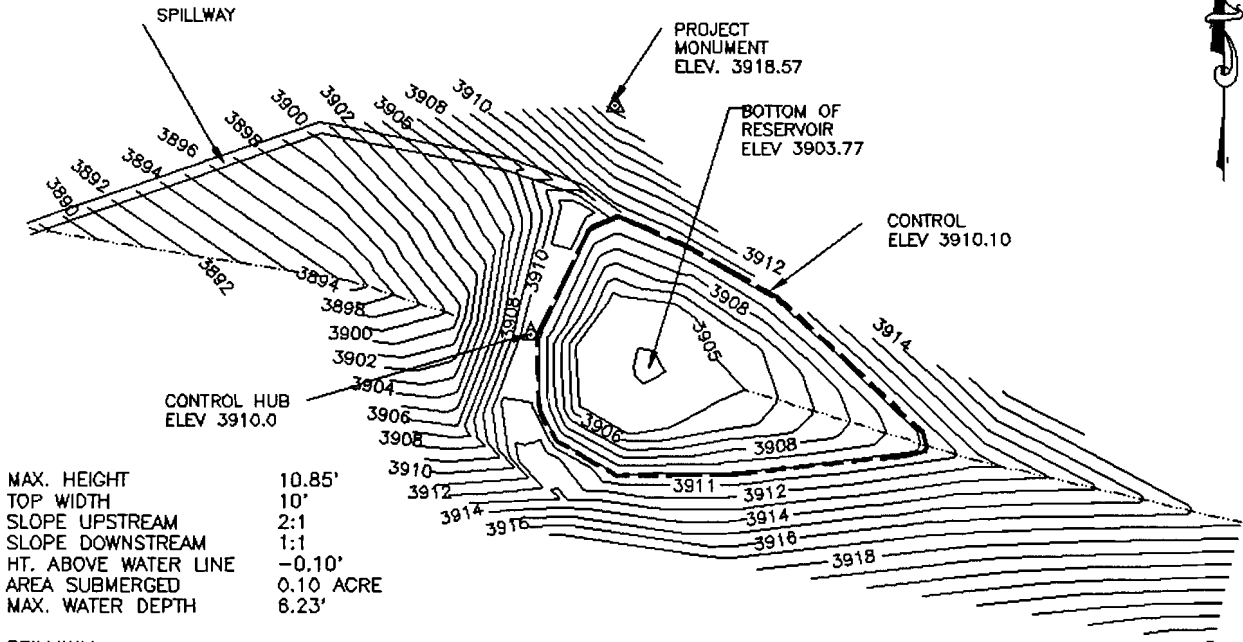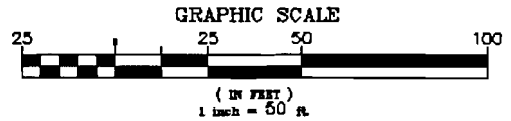

SPILLWAY:
BOTTOM WIDTH 5.0'
TOP WIDTH 26.0'
SPILLWAY CREST TO
DAM CREST -1.10
STORAGE CAPACITY 0.30 ACRE FEET

NOTE: CONTROL HUB
HAS AN ASSUMED
ELEVATION OF 3910.00 FROM
U.S.G.S. QUAD OXMAN, OREG.



FAILURE OF THIS STRUCTURE WOULD NOT
POSE A THREAT TO LIFE OR PROPERTY.

INSTALLATION OF AN OUTLET CONDUIT
WOULD THREATEN THE INTEGRITY OF THE
EXISTING STRUCTURE. SHOULD AN OUTLET
CONDUIT BE REQUIRED LATER FOR WATER
DISTRIBUTION NEEDS, IT WILL BE IN-
STALLED USING APPROPRIATE SAFEGUARDS
AND CONSTRUCTION TECHNIQUES, OR THE
STRUCTURE MAY BE BREACHED OR RE-
CONSTRUCTED.

JDR NO: 58-4556
WATER RIGHTS
APP. NO.:
WATER RIGHTS
PERMIT NO.

ACAD 11/DCA
PLSVALL2.DWG

UNITED STATES DEPARTMENT OF THE INTERIOR
BUREAU OF LAND MANAGEMENT
DIVISION OF OPERATIONS VALE DISTRICT

PLEASANT VALLEY
WATERHOLE #2 (58-4556)
RESERVOIR AS BUILT

DESIGNED FIELD SURVEY 10/14/92 GRASBY & CARTER
REVIEWED *James R. Pritchard*
APPROVED *George D. House*
CHIEF, BRANCH OF ENGINEERING

DRAWN: C.G. SCALE: 1"=50'
DATE: DATE SHEET 1 OF 1
DRAWING NO. DR-03-9172.45-145

RECEIVED

SEP 30 1993

WATER RESOURCES DEPT.
SALEM, OREGON


"CERTIFICATE NO. 03085"

APPLICATION MAP FOR PERMIT TO CONSTRUCT A RESERVOIR

GOV'T. LOT 4 SEC 19 T 10S R 42E W.M.


U.S.G.S. QUAD - OXMAN & ENCINA, OREG. - 7 1/2'

RECEIVED
SEP 30 1993
WATER RESOURCES DEPT.
SALEM, OREGON

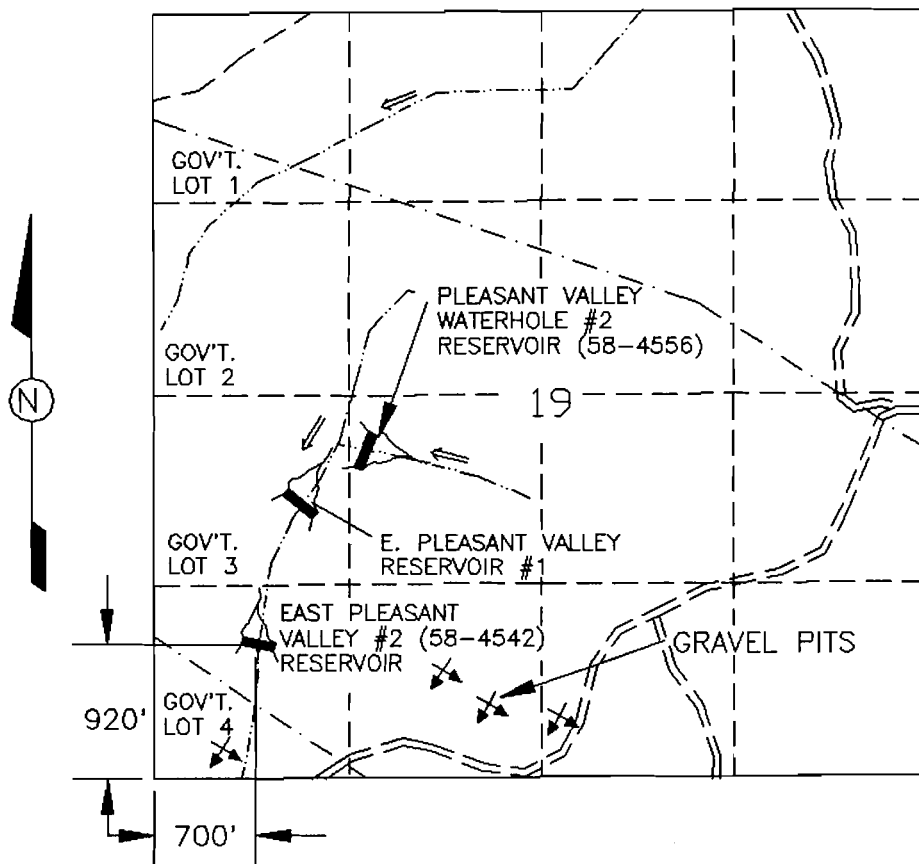


LEGEND

- RESERVOIR
- ROAD
- TRAIL
- CREEK
- POWER LINE
- GRAVEL PITS

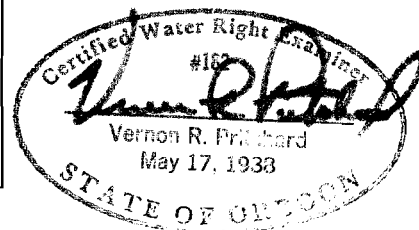

EAST PLEASANT VALLEY (58-4542) RESERVOIR #2

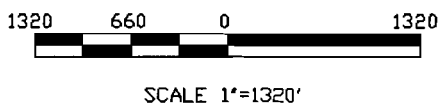

THIS MAP IS FOR THE PURPOSE OF LOCATING A WATER RIGHT AND IS NOT INTENDED TO PROVIDE LEGAL DIMENSIONS FOR LOCATION OF PROPERTY BOUNDARIES.



ACAD RELEASE 11/DCA
DWG FILE: EPLSAPP

UNITED STATES DEPARTMENT OF THE INTERIOR
BUREAU OF LAND MANAGEMENT
DIVISION OF OPERATIONS VALE DISTRICT

EAST PLEASANT VALLEY RESERVOIR #2 (58-4542)

DESIGNED *Vernon R. Pritchard*
REVIEWED
APPROVED *George D. House*
CHIEF, BRANCH OF ENGINEERING

DRAWN: CG SCALE: 1"=1320'

DATE: 05/11/93 SHEET 1 OF 1

DRAWING NO. DR-03-9172.45-146

R-73660

FORM 140

CERTIFICATE NO. 02085