


T 13 S R 16 E
 Section 8
 SW 1/4 NW 1/4

Scale
 1" = 400'

RECEIVED
 AUG 1 1979

WATER RESOURCES DEPT
 SALEM, OREGON

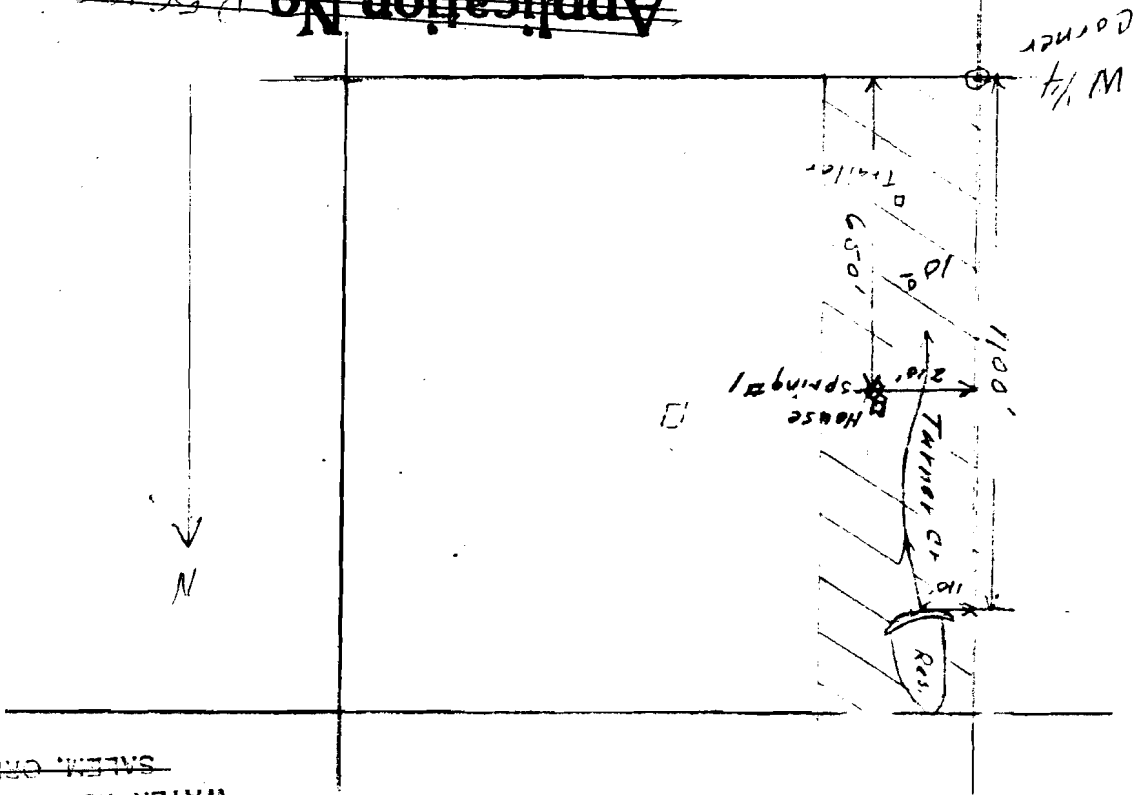

~~Application No. R 51169459115~~
~~Permit No. H 5123 44817~~

Application No. 2-74915
Permit No.
RECEIVED

69343
 NOV 15 1994

CERTIFICATE NO.
 WATER RESOURCES DEPT
 SALEM, OREGON

No Final Proof Map available

No Permit Map available