


THIS MAP WAS PREPARED FOR  
ASSESSMENT PURPOSE ONLY  
AVAILABLE FROM DCGIS

SECTION 26 T28S R5W WM  
DOUGLAS COUNTY

Application No. R-75399  
Permit No.

REVISED ON  
6/24/92


28 5 26
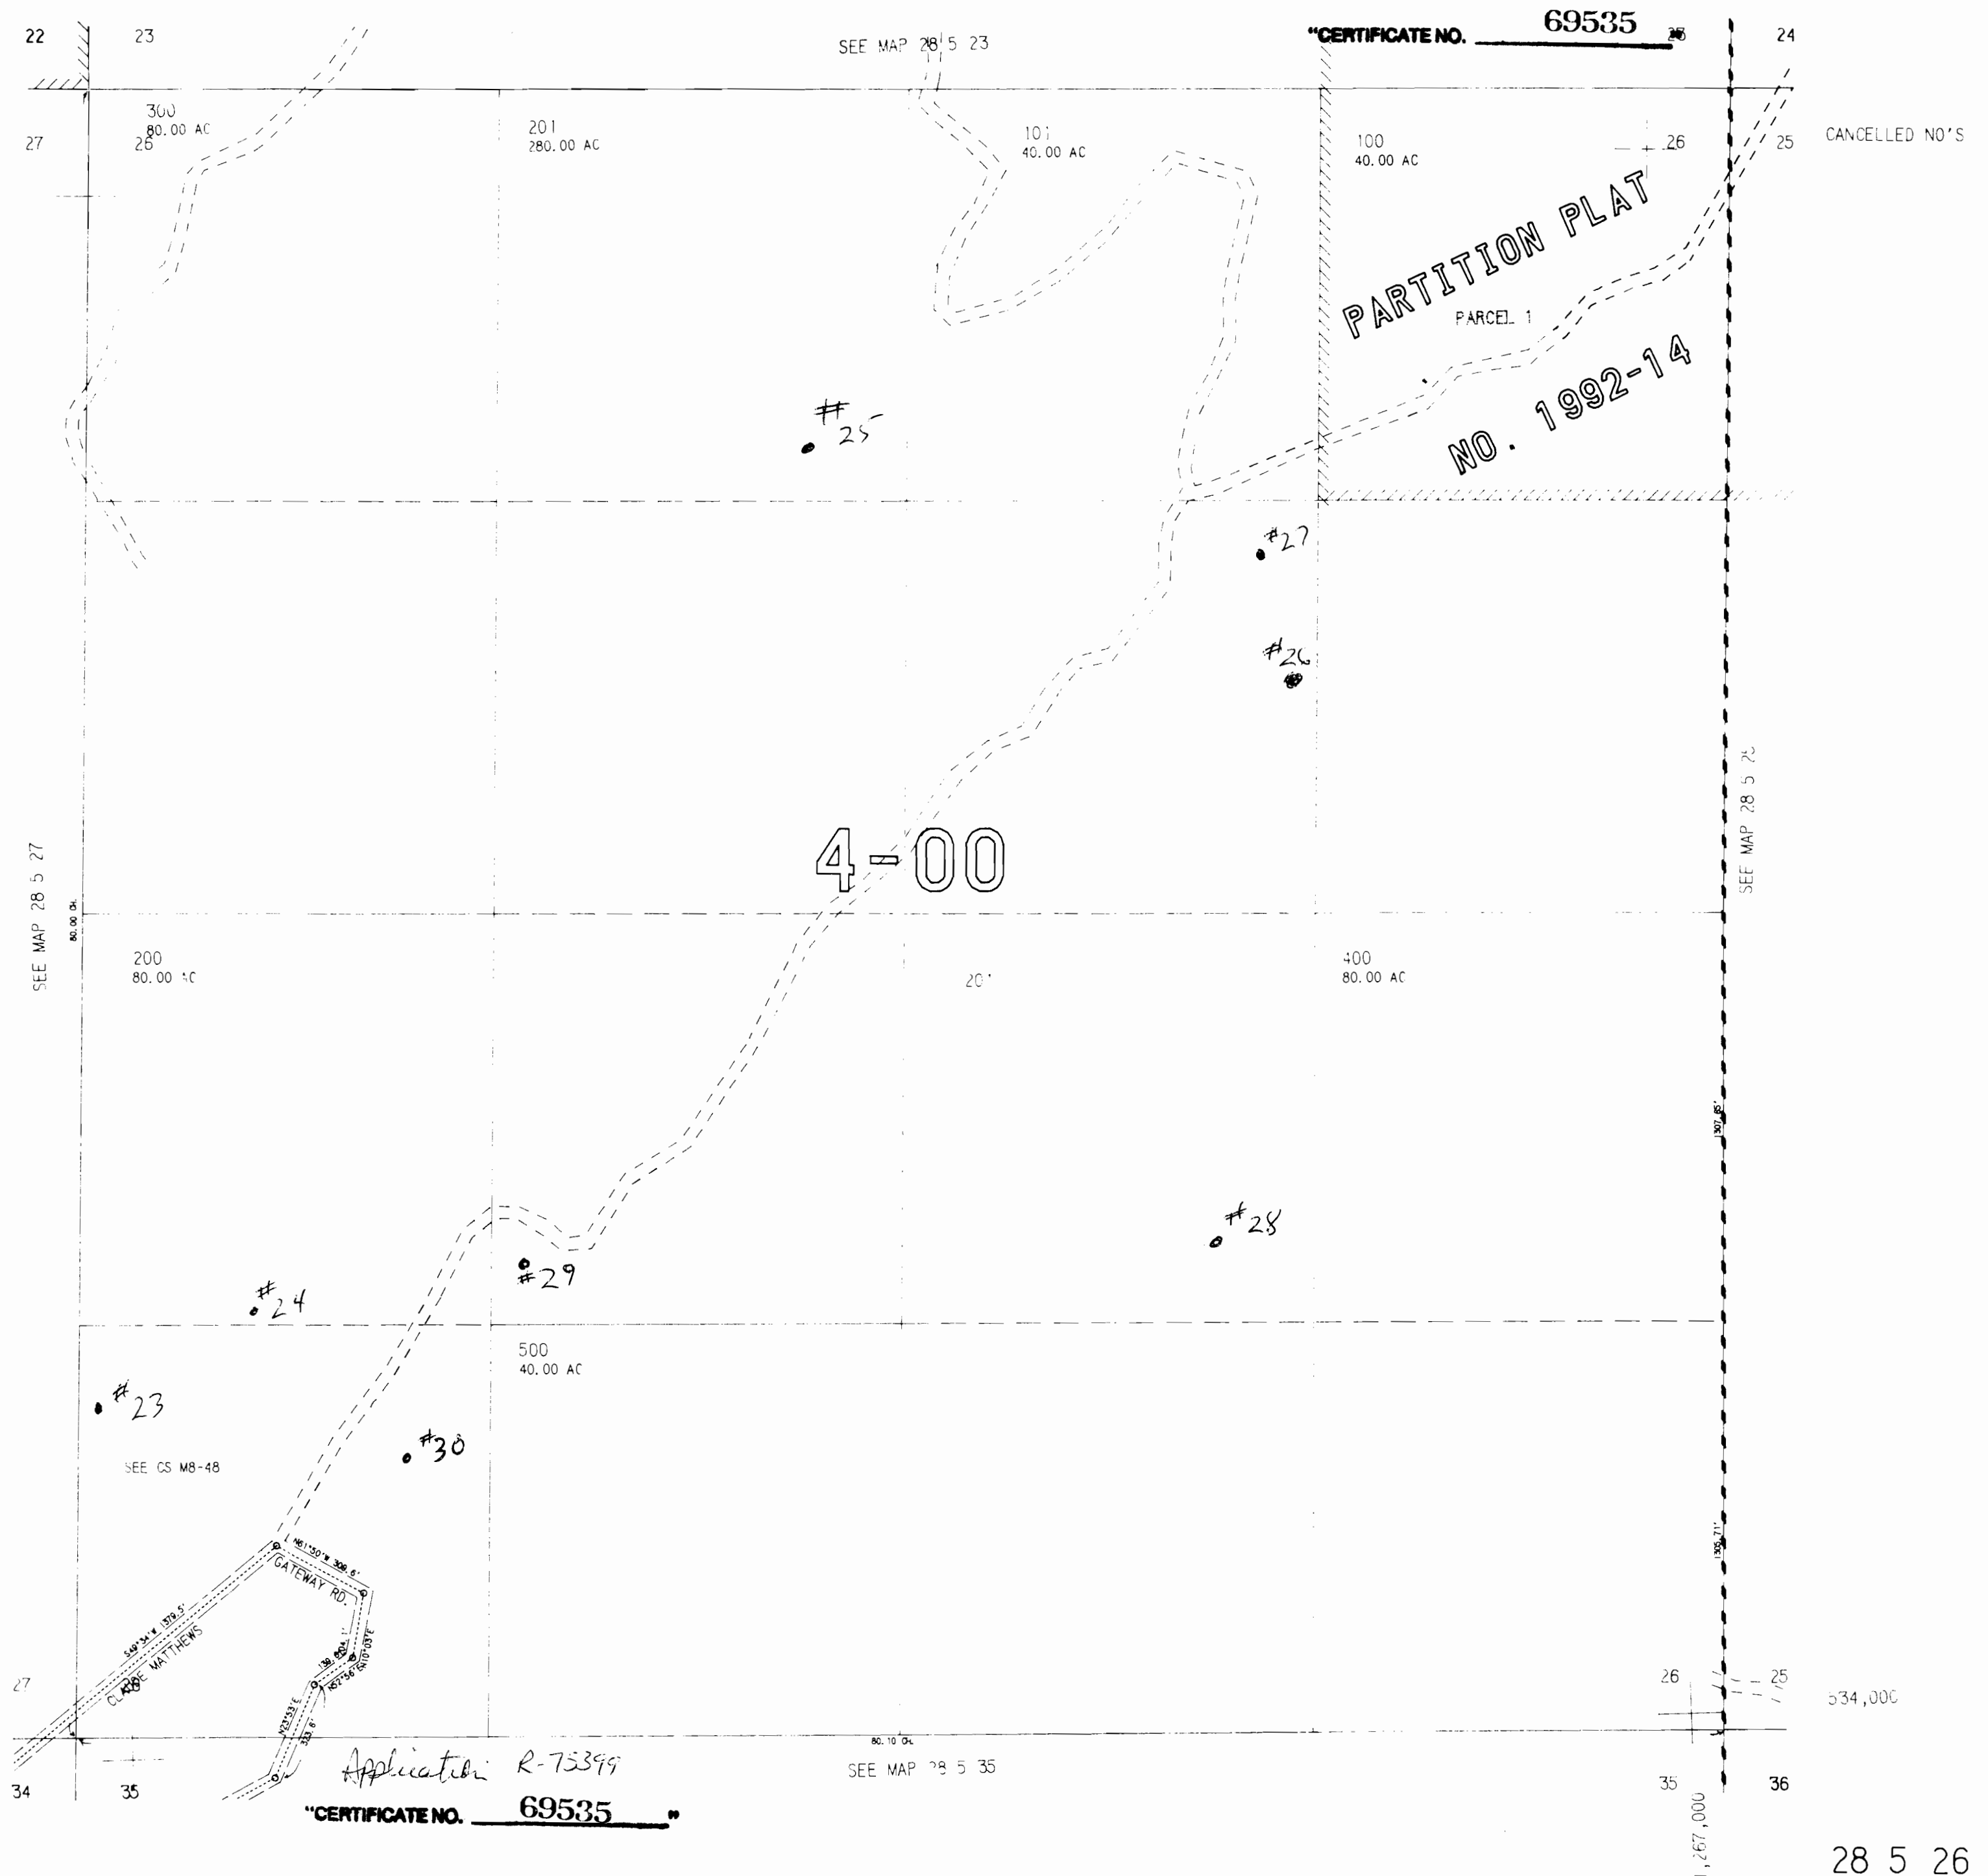
$$1'' = 400'$$


1"-400'

Application No. R-75399  
Permit No.

22 | 23

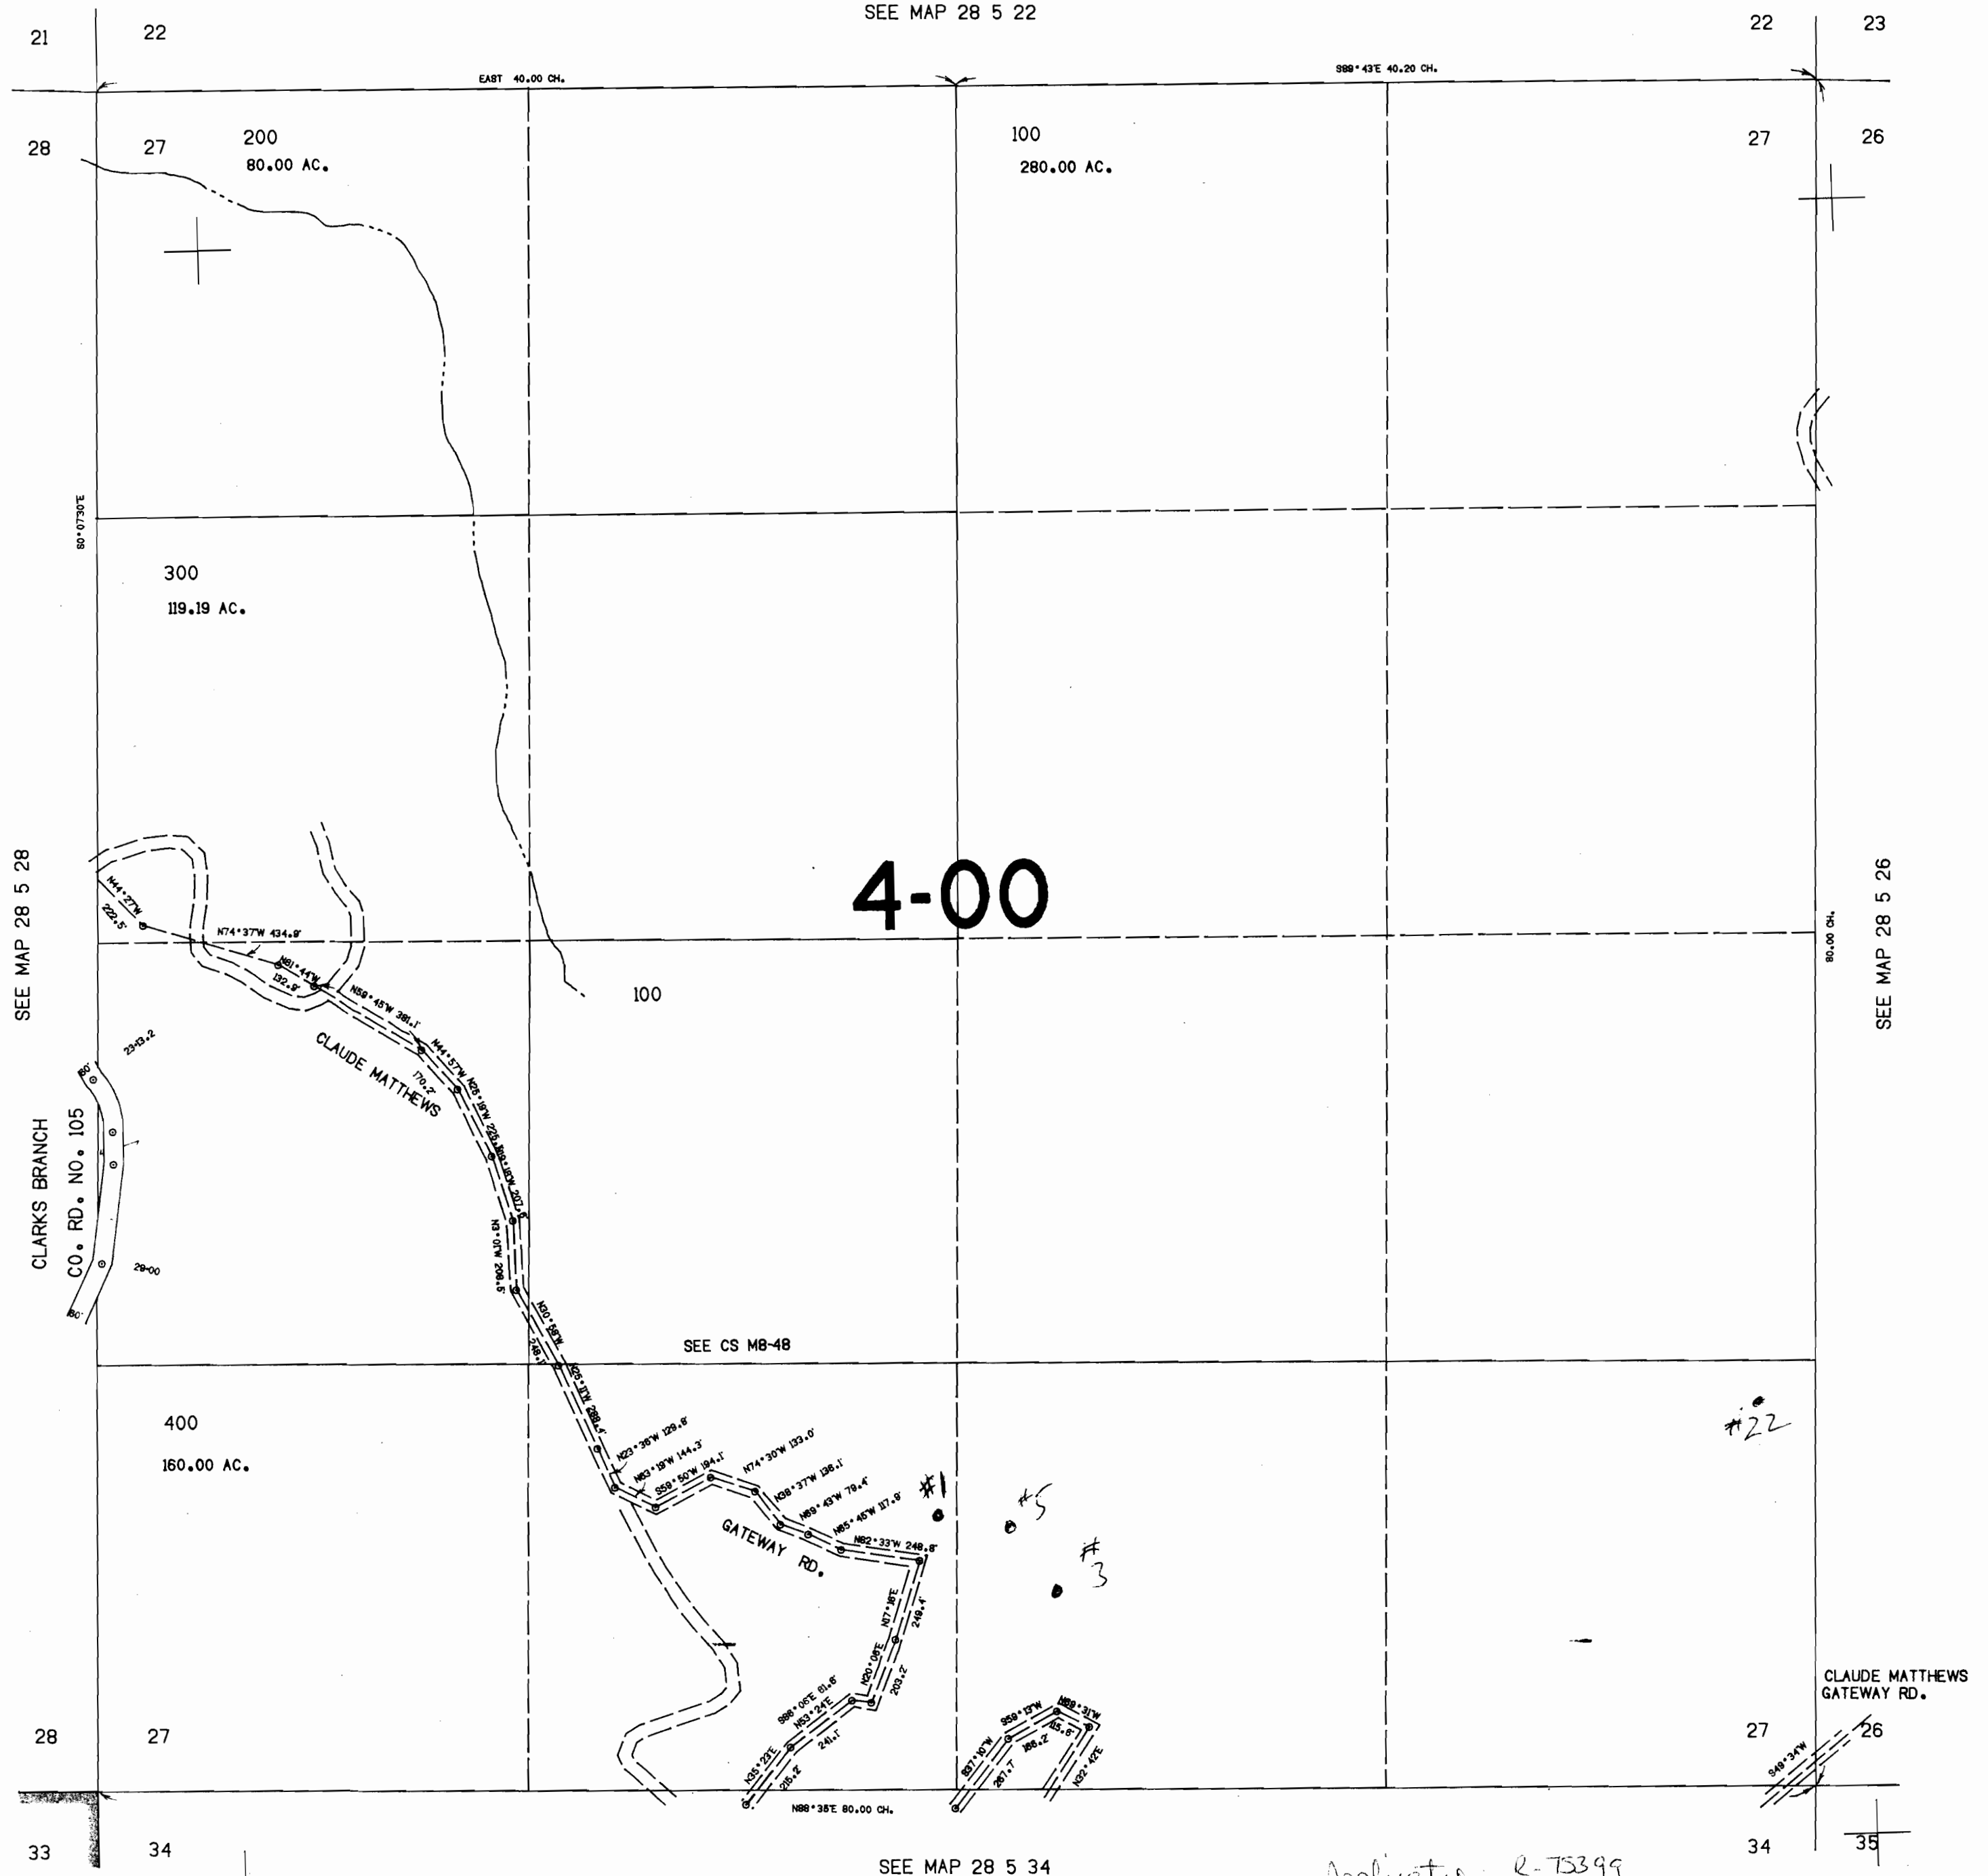

534

Applicant: R-75399  
"CERTIFICATE NO. 69535"

28 5 27

1,262,000

SECTION 35 T.28S. R.5W. W.M.  
DOUGLAS COUNTY

1"=400'


Application No. R-75399  
Permit No.

THIS MAP WAS PREPARED FOR  
ASSESSMENT PURPOSE ONLY.

Application R-75399

CERTIFICATE NO. 69535

SEE MAP 28 5 26

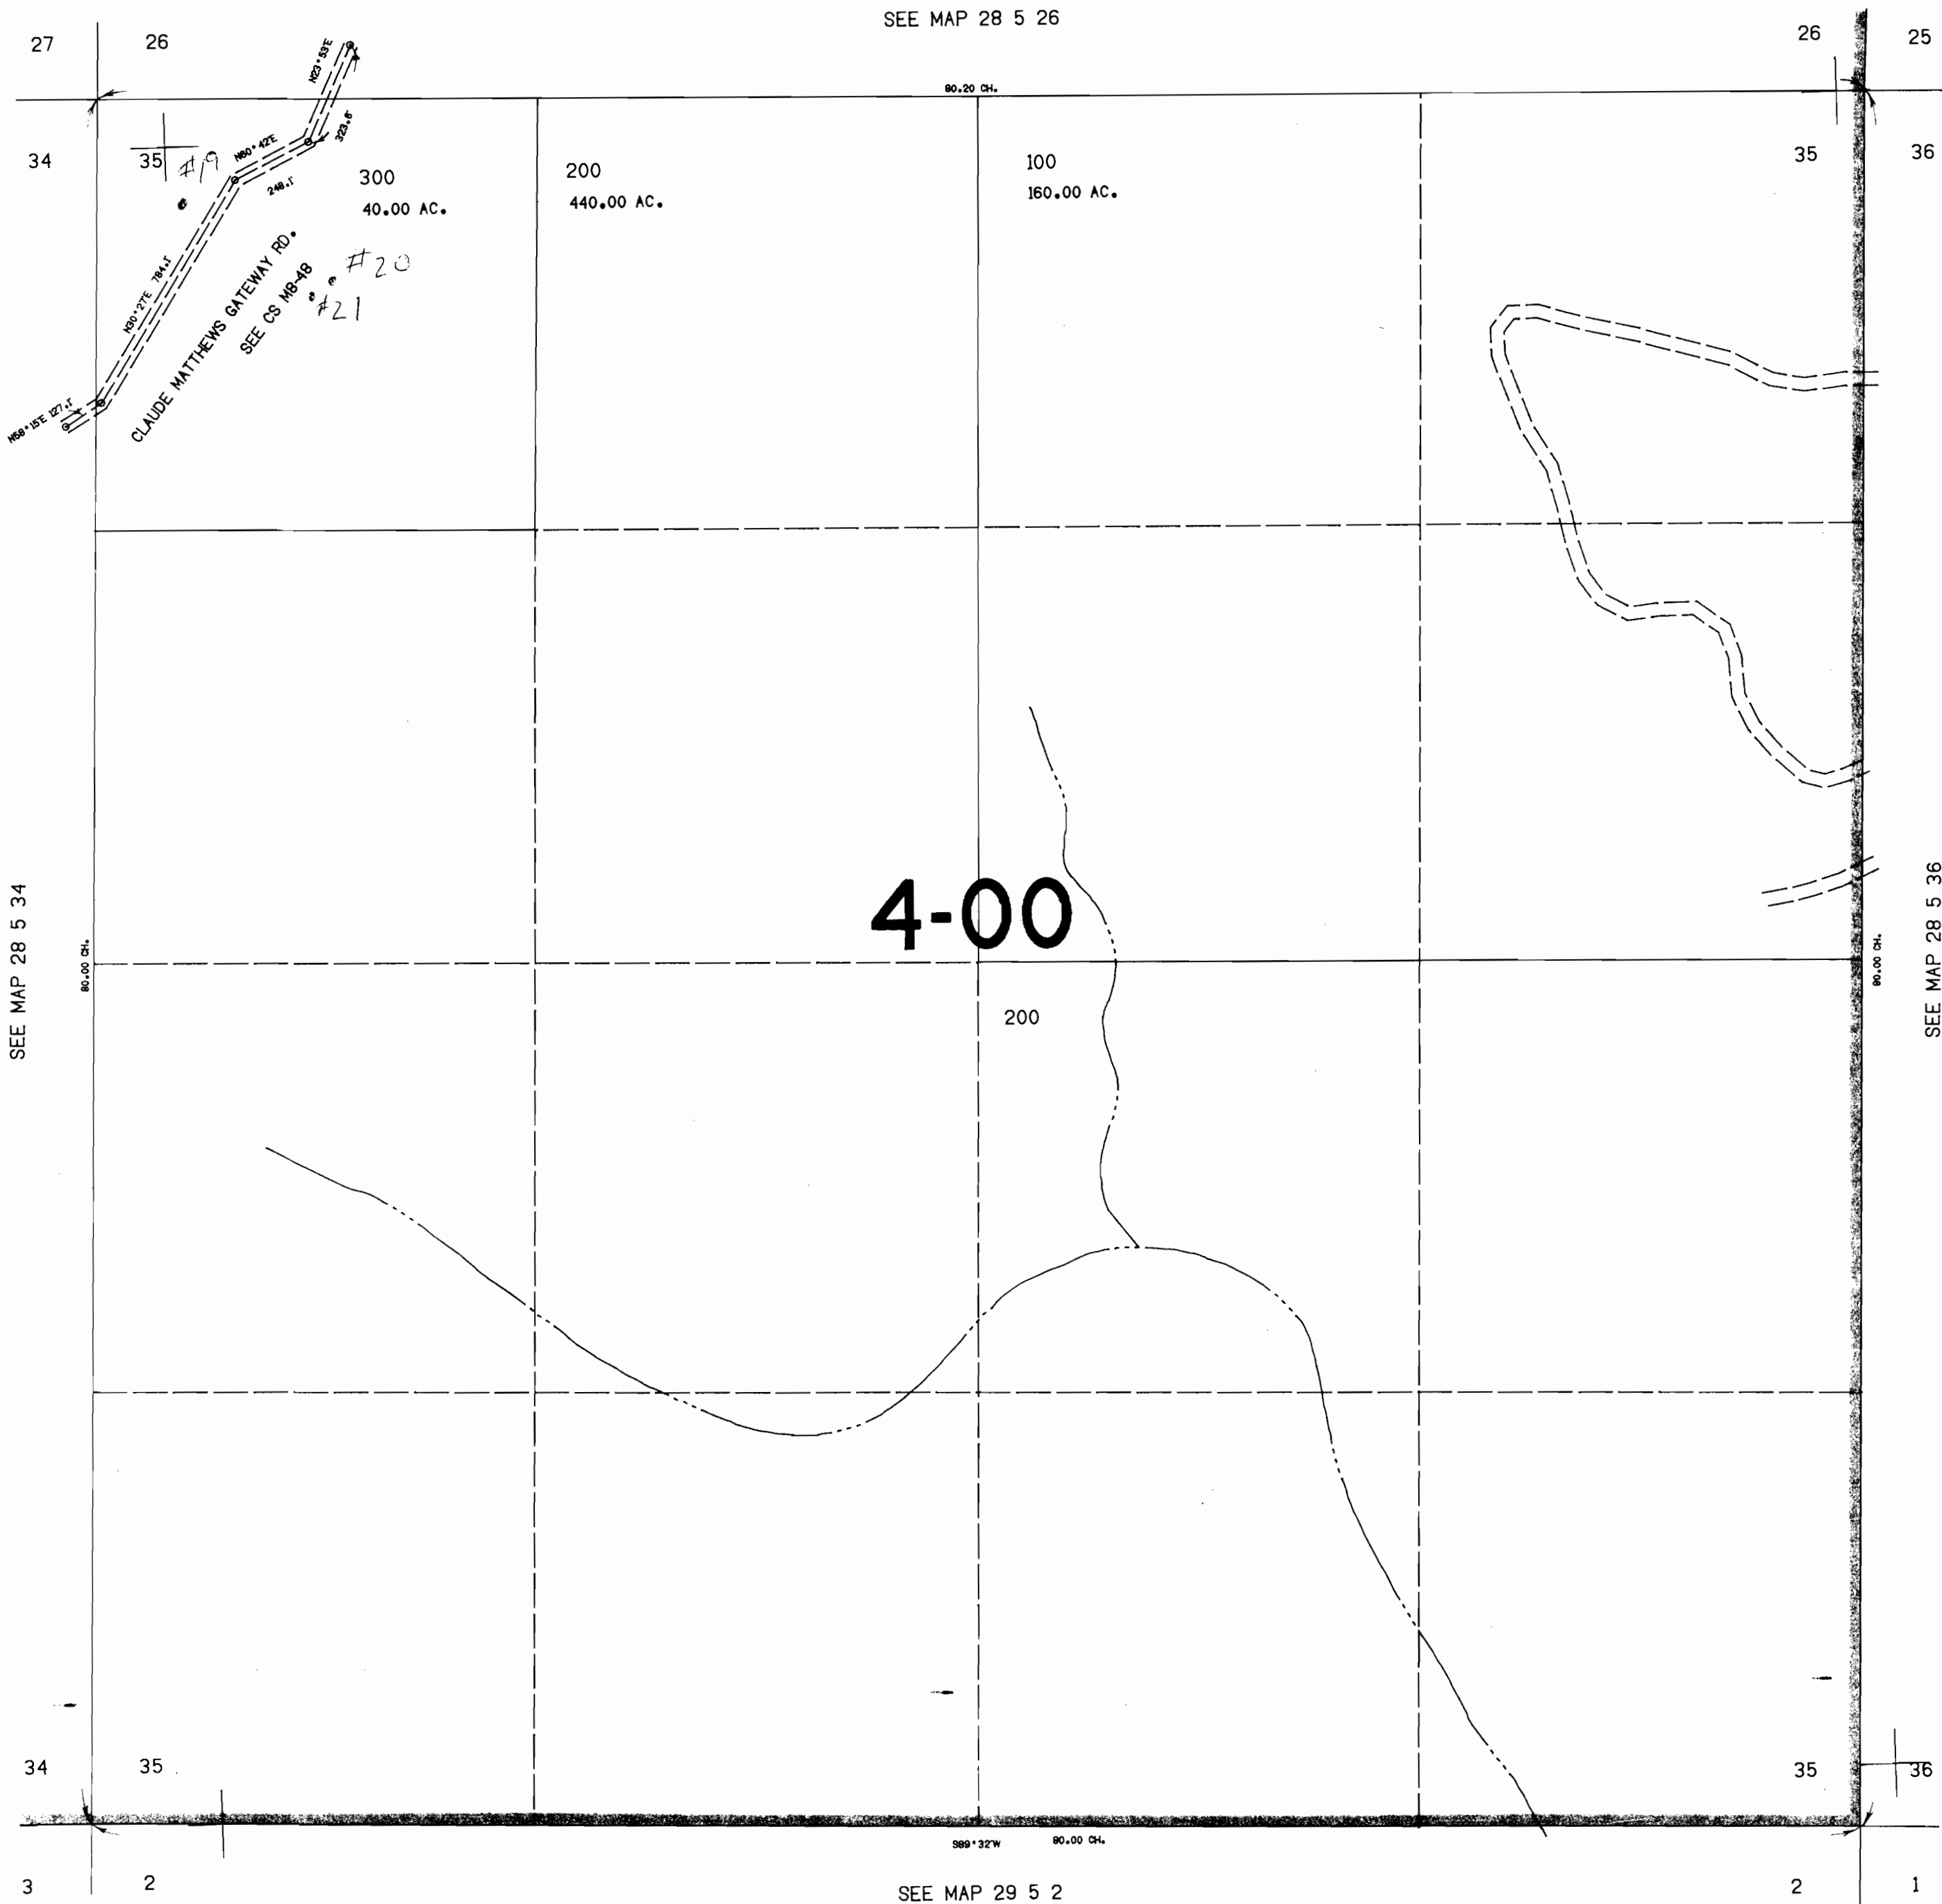

529.000

SECTION 34 T.28S. R.5W. W.M.  
DOUGLAS COUNTY

28 5 34


THIS MAP WAS PREPARED FOR  
ASSESSMENT PURPOSE ONLY.

1"=400'

Application No R-75399  
Permit No.

Application R-75399  
"CERTIFICATE NO. 69535"

"CERTIFICATE NO. 69535"

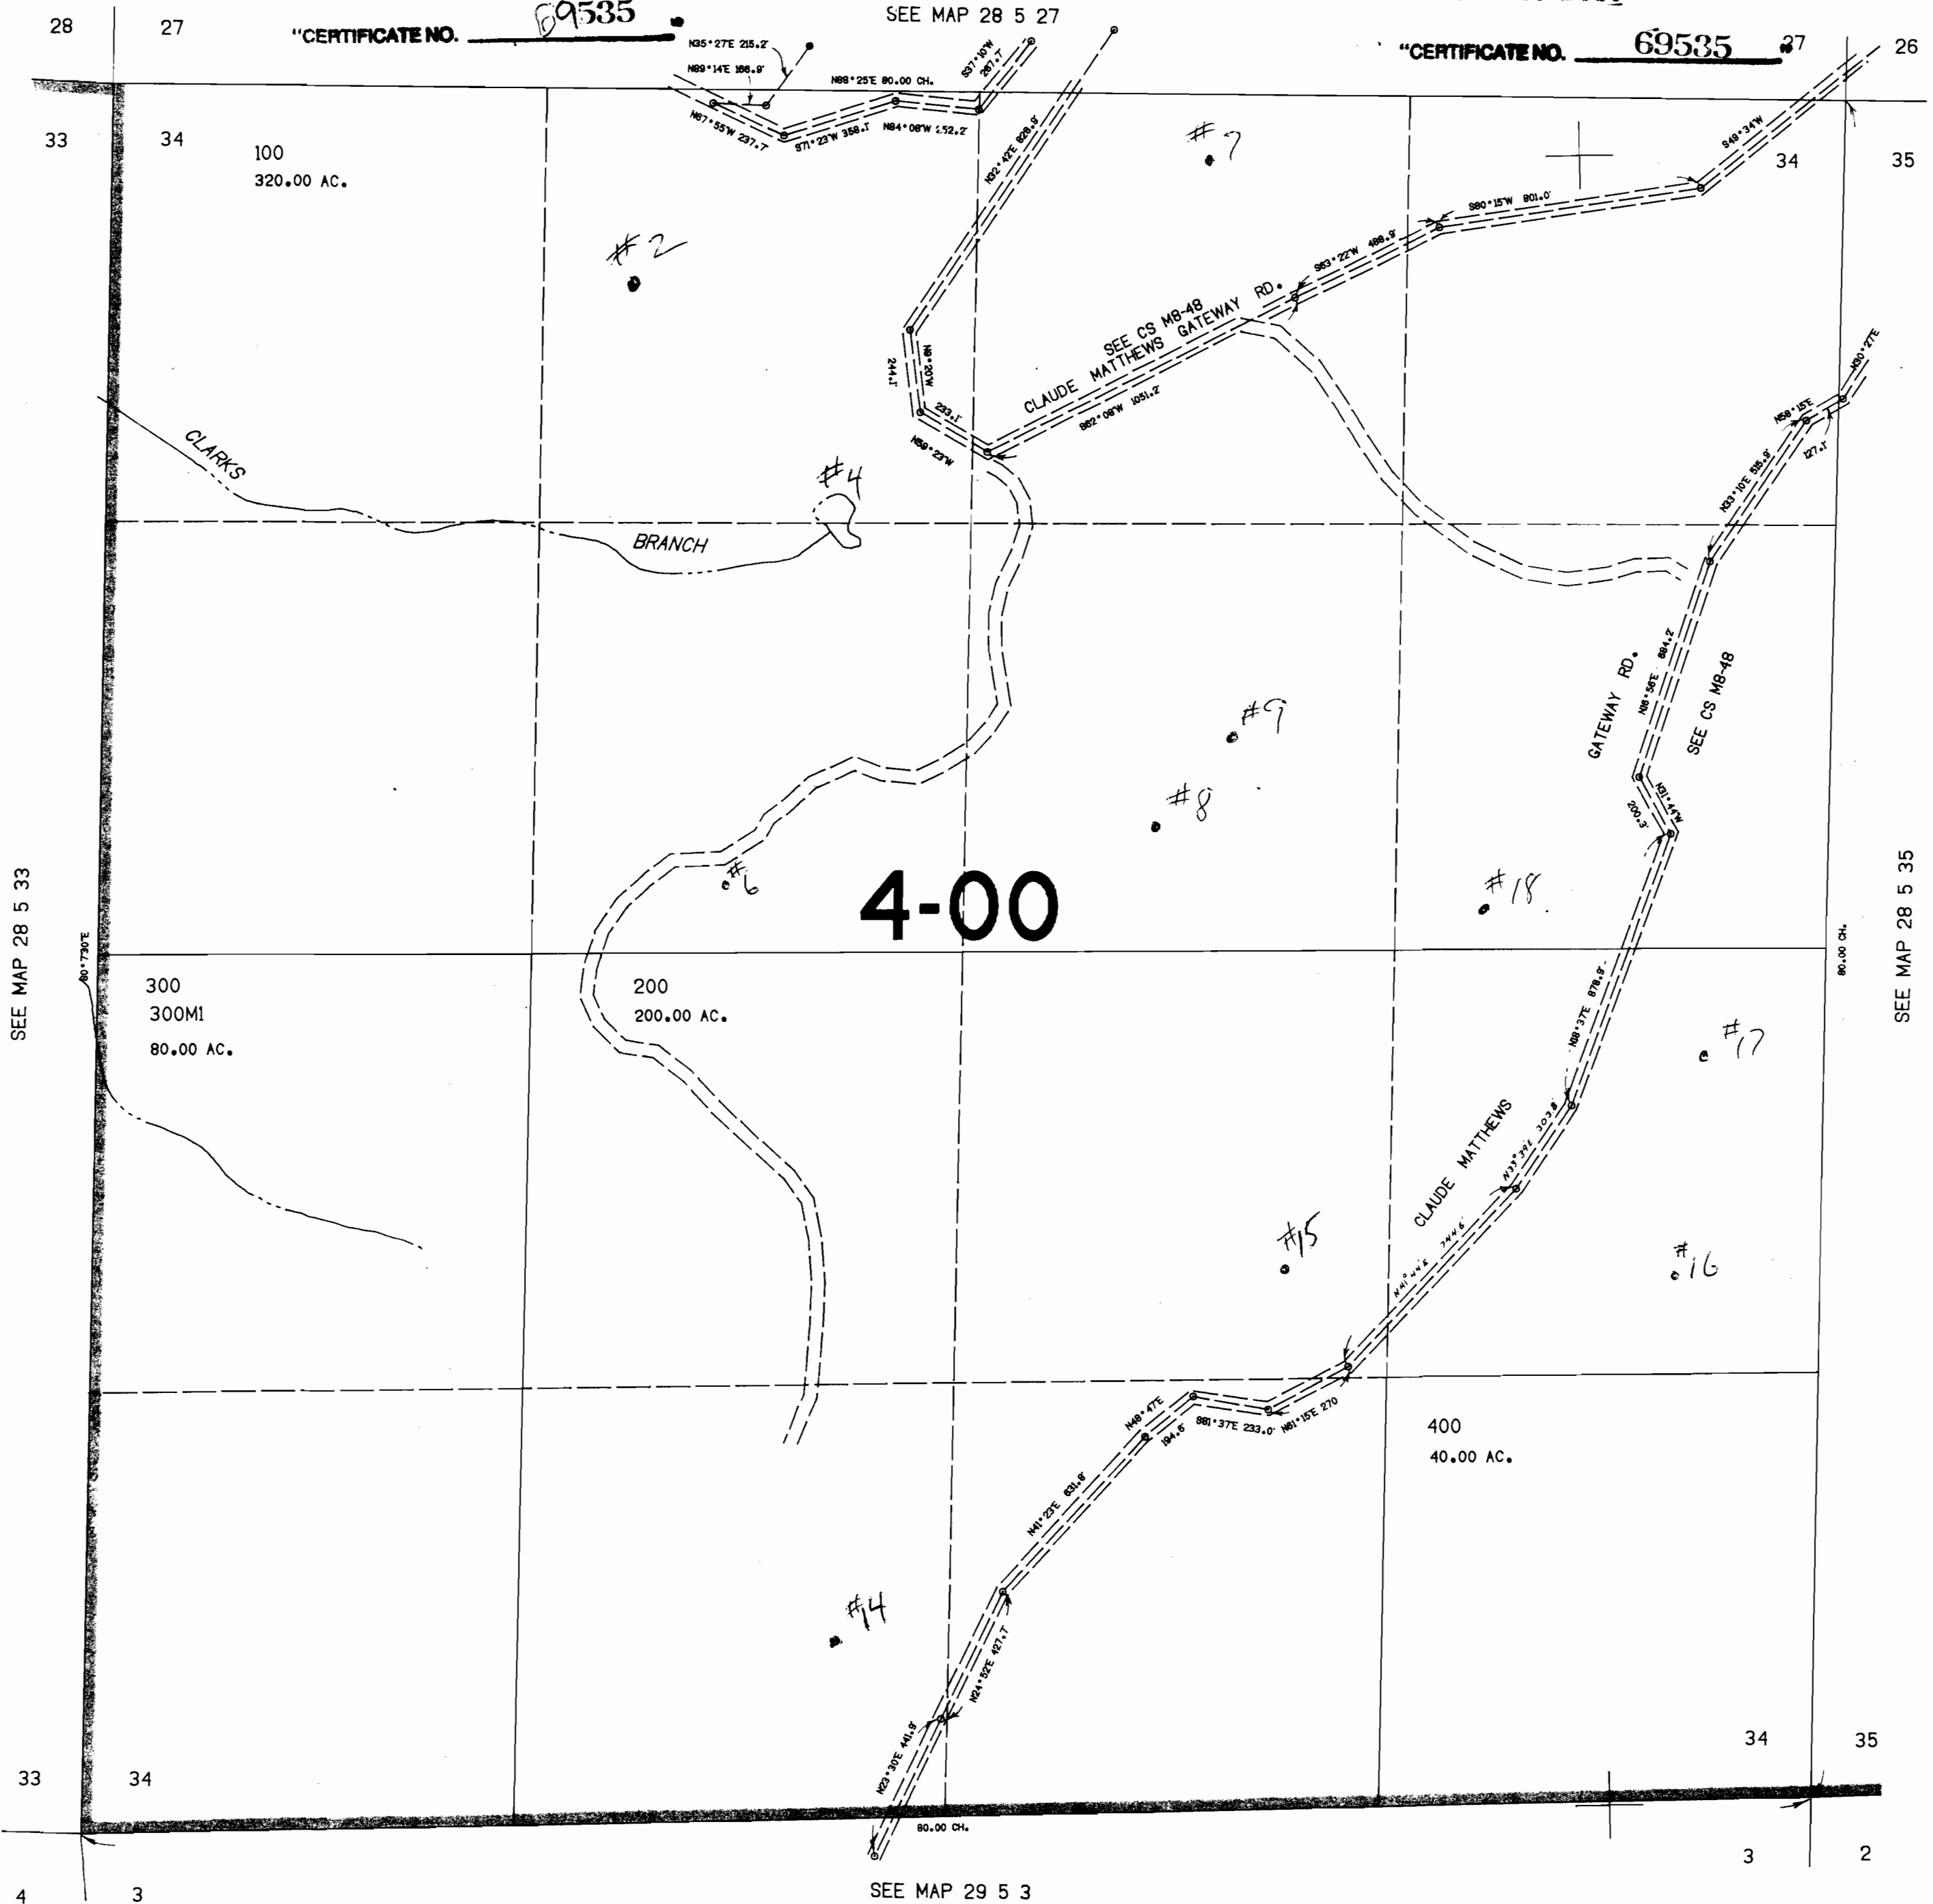

529.000

28 5 34

SECTION 4 T.29 S. R. 5 W. W.M.  
DOUGLAS COUNTY

REVISED ON  
10-5-92

69535

Application No. R-75399  
Permit No. 33 34

This report was prepared for  
~~internal use only. Do not~~ ~~release~~ ~~only~~

$$1'' = 400'$$

SEE MAP 28 5 33

5291.02'  
589°59'42"E

APPROX 1/4 COR.

2645. B

32 33

|   |   |                            |
|---|---|----------------------------|
| 5 | 4 | 200<br>200MI<br>202.98 Ac. |
|---|---|----------------------------|

100  
162.98 Ac.

4

LOT 41.49  
RICHARDSON

LOT 41.49

LOT 41.49

LOT 41 45

#12

© 2000 Blackwell Science Ltd *Journal of Internal Medicine* 247: 115–121

200 MI

19-00

#1

✓ APPROX  
✓ 1/4 COR

APPROX.  
1/4 COR.

C.S. 29  
M8:

300  
40.00Ac

400  
20000Ac

CS-130

13

500  
40.00Ac.

1000

525,000

SEE MAP 29 S E

SFF MAP 29 5 3

SEE MAP 29 5 9

00:55:00

SECTION 3 T.29S. R.5W. W.M.  
DOUGLAS COUNTY

$$l'' = 400'$$

Application No. R-75399  
Permit No.

This map was prepared for  
assessment purpose only.

Application: R 75399

**"CERTIFICATE NO.**

33

34

SEE MAP 28 5 34

34

35

$$80 \text{ Ch} = 5280'$$

4

3

300  
121.48 AC

#10

LOT 41.48

100  
164 08 AC.

LOT 41.42

LOT 4136

LOT 4130

3

2

135828

2066 320

50° 10' E.

SEE MAP 29 5 2

SEE MAP 29 5 4

30° 30' E

40 CH 2640

4

3

SEE M 5-38

WEST 80 44 Cn = 5309.04'

SEE MAP 29 5 10

10

19

905.4 2640

525,000

19-00

400  
280 00 AC.

ROCK CREEK

1,260,000