

RECEIVED

DEC 29 1994

WATER RESOURCES DEPT.
SALEM, OREGON


RECEIVED

DEC 20 1994


WATER RESOURCES DEPT.
SALEM, OREGON

CERTIFICATE NO. 70770

Application No. 2-7685
Permit No.

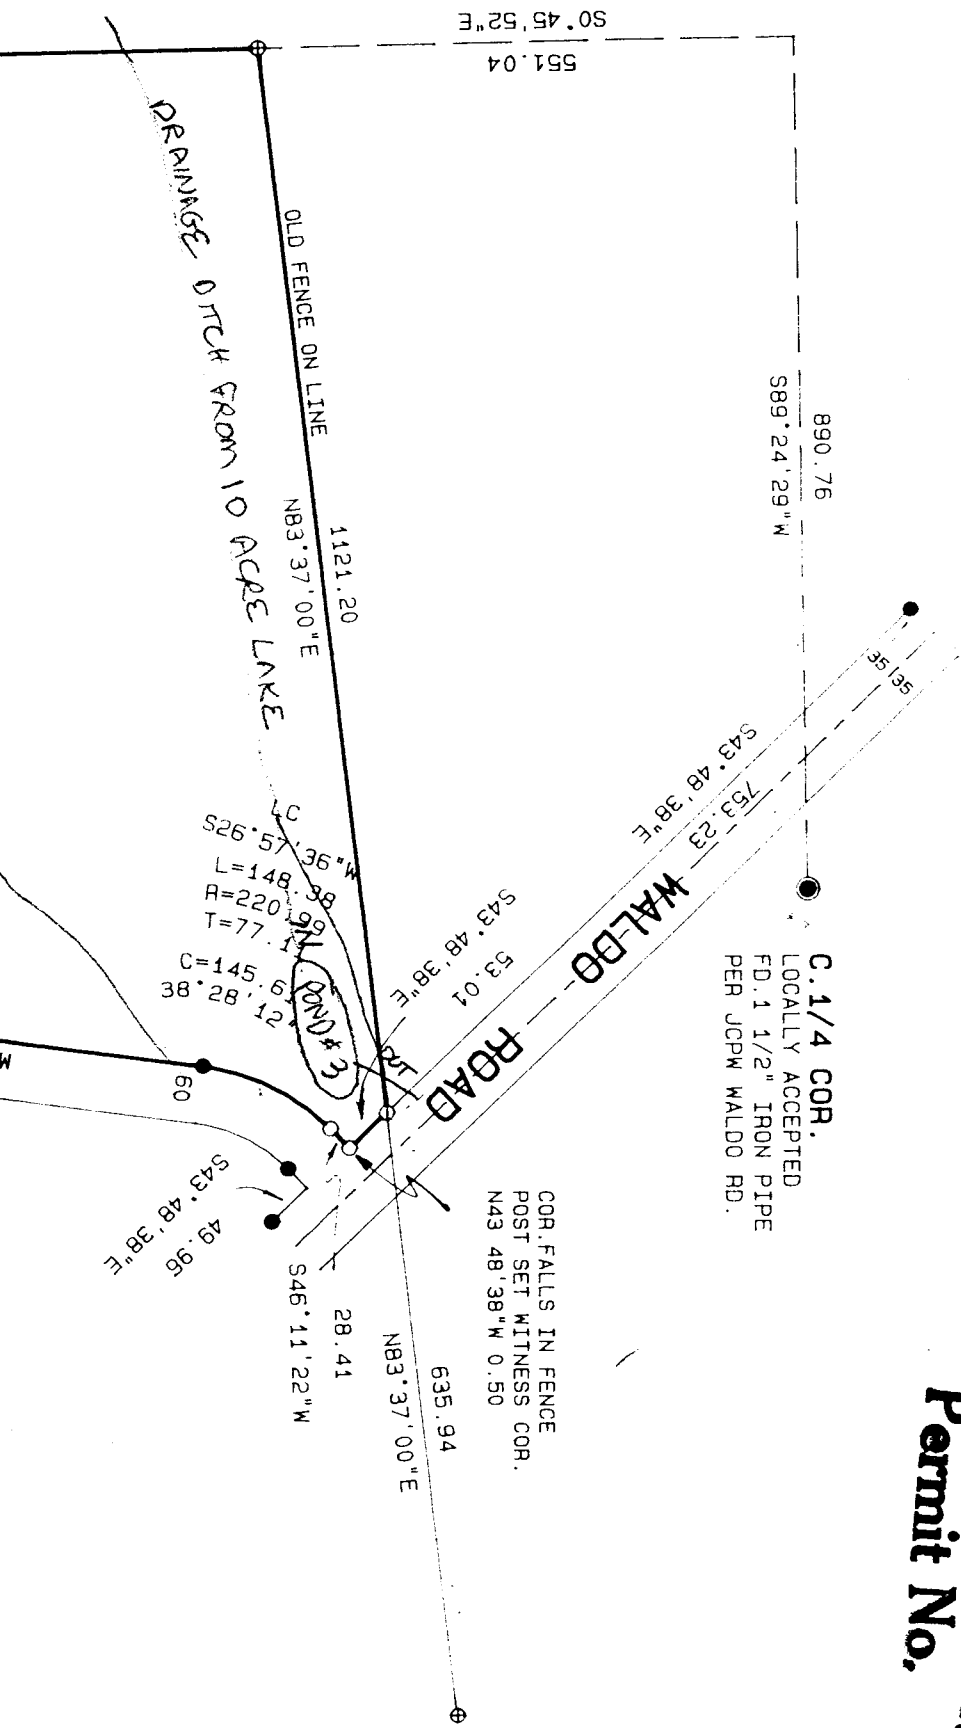

NOTE: THIS PORTION OF O'BRIEN ROAD R/W IS BASED ON CS 140-62 & UDEE SUB. & MAY BE SUBJECT TO CHANGE BY JCPW

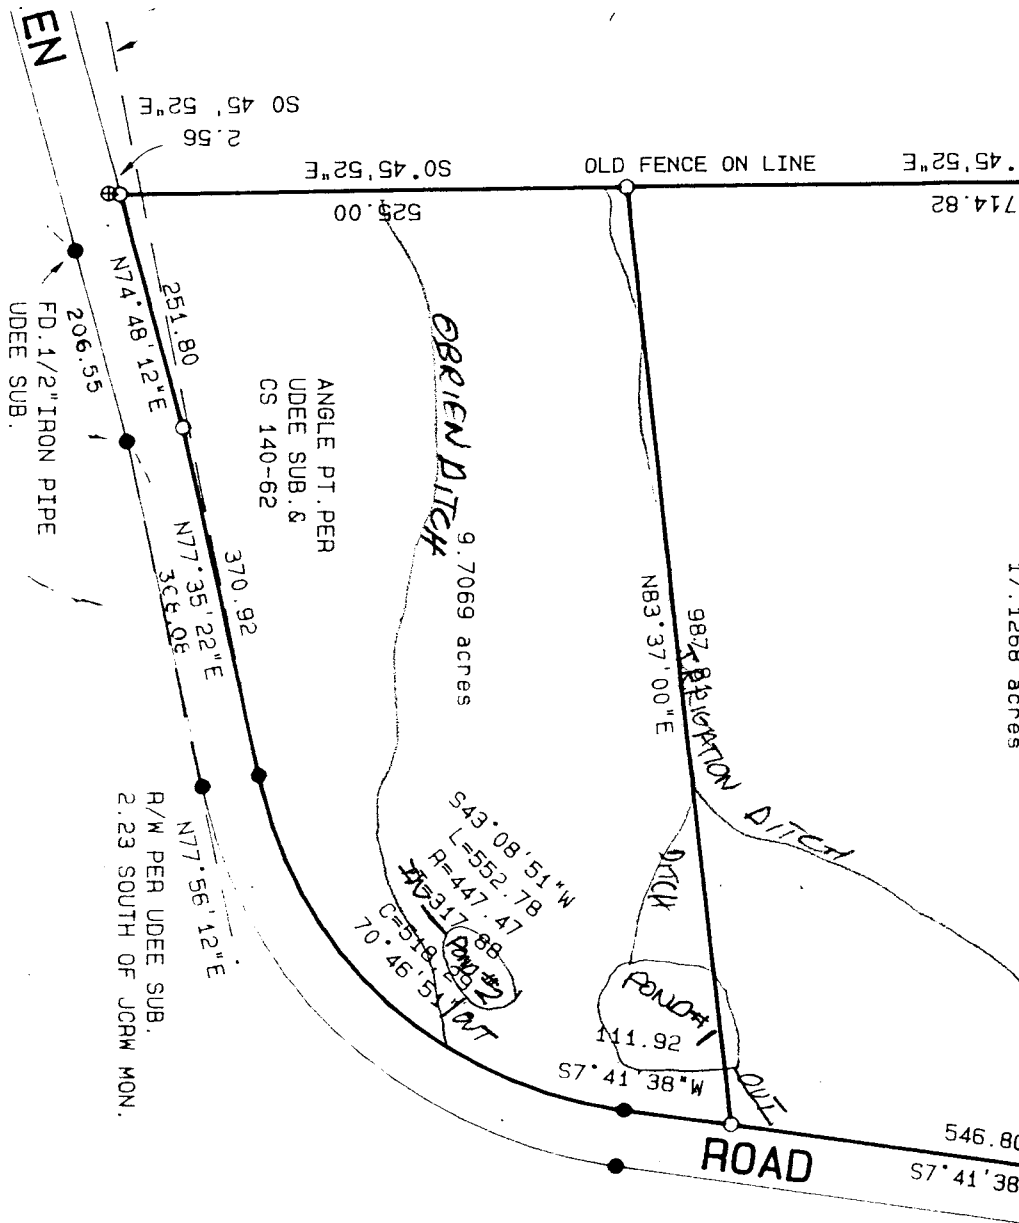


[Handwritten signature]

MAP

RUNNING A SURVEY IN THE S. 1/2
SECTION 19, TWP. 40 S., R. 8 W.,
JOSEPHINE COUNTY, OREGON

SURVEYED FOR:

~~MIKE VAN DAM & Deceased~~

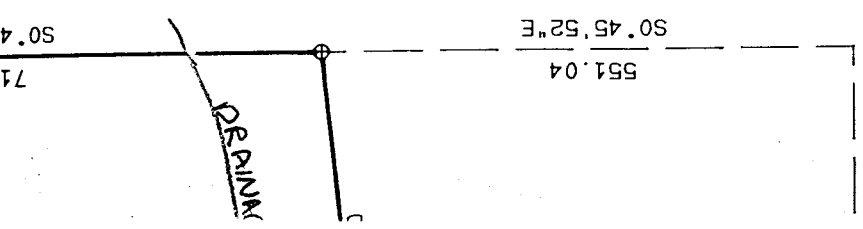

~~MIKE VAN DAM~~ S. Deceased
 HELEN EARLY
 5404 PIONEER RD. 772 O'BRIEN RD
 HUGHSON CA O'BRIEN, OR 97534

SURVEYED BY:
 MAX H. HULL SURVEYING
 231 NW "B" STREET
 GRANTS PASS, OREGON

LEGEND

- SET 5/8" X 30" IRON RODS WITH YELLOW PLASTIC CAPS MARKED "HULL RS 901"
 - FOUND 5/8" IRON RODS PER JCPW DEPT. UNLESS OTHERWISE NOTED
 - ⊕ FOUND 3/4" IRON PIPES PER OS 52-64 BASIS OF BEARING OS 52-64
- SCALE: 1" = 200'
 FEBRUARY 12, 1993

