


SECTION 7

~~NW 1/4 NE 1/4~~
A

TOWNSHIP 38^S RANGE 43^E W.M.

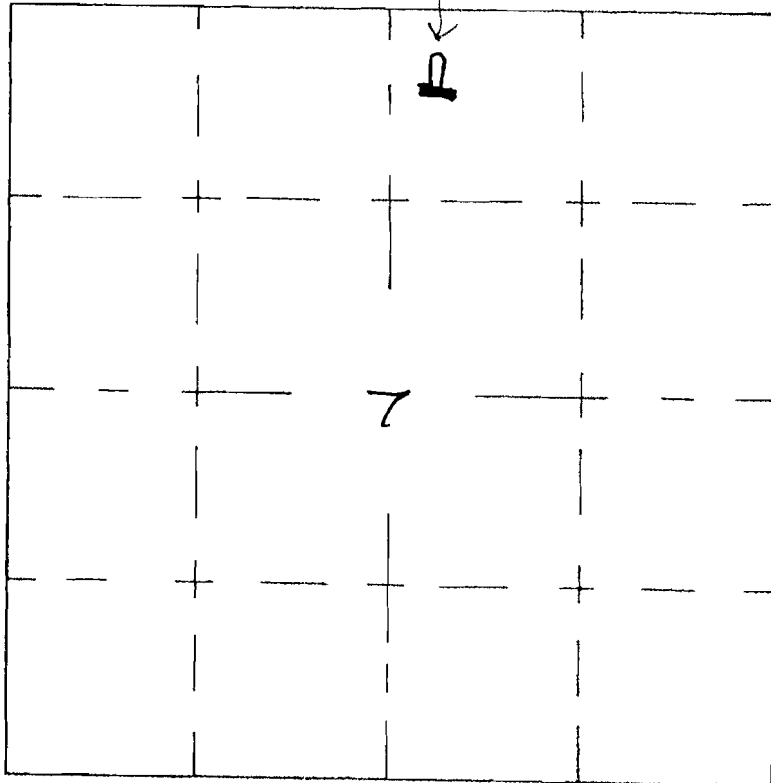

Application No. **R59110**

Permit No. **R 8747**

U. S. DEPARTMENT OF THE INTERIOR
BUREAU OF LAND MANAGEMENT

^{Mtn'}
BLUE # 4

DESIGNED _____

RECOMM. _____

DRAWN _____

RECOMM. _____

CHIEF, DIV. OF ENG.

CHECKED _____

APPROVED _____

SCALE _____

DATE _____

SHEET _____ OF _____

DRAWING NO. _____

RECEIVED


AUG - 1 1997

WATER RESOURCES DEPT.
SALEM, OREGON

SECTION 7

~~NW 1/4 NE 1/4~~
4

TOWNSHIP 38 S RANGE 43 E W.M.

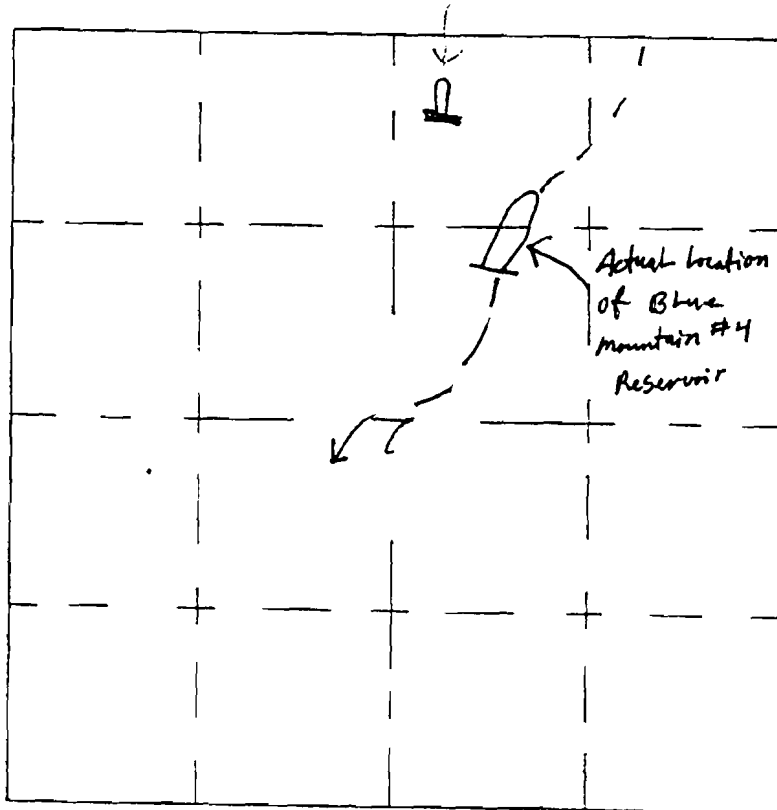

Application No. R59110

Permit No. R 8797

U. S. DEPARTMENT OF THE INTERIOR
BUREAU OF LAND MANAGEMENT

^{MTN}
BLUE # 4

DESIGNED _____

RECOMM. _____

DRAWN _____

RECOMM. _____

CHIEF, DIV. OF ENG.

CHECKED _____

APPROVED _____

SCALE _____

DATE _____

SHEET _____ OF _____

DRAWING NO. _____