



T.37S.,R.2E.,W.M.

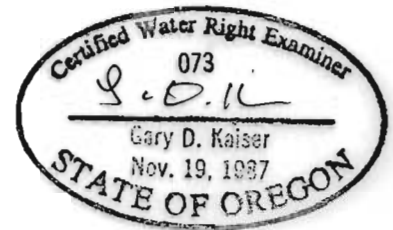

SCALE 1" = 400'

NOTE: MAP PREPARED FOR
WATER RIGHT PURPOSES ONLY,
NOT FOR PROPERTY BOUNDARY
LOCATIONS.

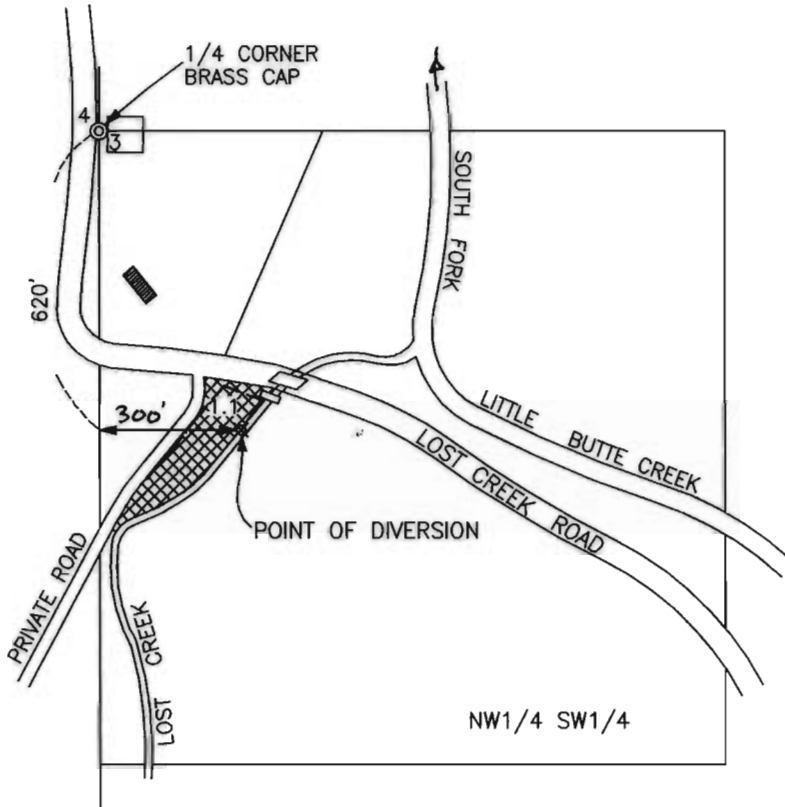

RECEIVED

OCT 03 2005

WATER RESOURCES DEPT
SALEM, OREGON

CLAIM OF BENEFICIAL USE MAP

APPLICATION FILE No. T-8211

IN THE NAME OF:
SHIRLEY STONE
5500 LOST CREEK ROAD
EAGLE POINT, OR. 97524

MAP PREPARED SEPTEMBER 15, 2005
BY GARY D. KAISER



= PORTION OF FORMER CERT.
17225, PRIORITY DATE 1885
MODIFIED BY T-8211 NEW
DIVERSION POINT AND NEW
PLACE OF USE, PRIMARY
IRRIGATION. ALSO PORTION OF
PERMIT NO. 3733, FORMER
CERT. 5783, PRIORITY DATE
FEBRUARY 16, 1918,
MODIFIED BY T-8211. NEW
DIVERSION POINT ~~AND NEW~~
~~PLACE OF USE~~ SUPPLEMENTAL
IRRIGATION

RECEIVED

DEC 01 2005

WATER RESOURCES ~~DEPT~~
SALEM, OREGON

RECEIVED