

~~W 1/2 of N.W 1/4 of~~
~~Point of diversion 1080 ft. S.E. from~~
~~T 5 S R. 10 W~~

SECTION 15 T.5S. R.10W. W.M.
TILLAMOOK COUNTY

5S 10 15


1"=400'

This map was prepared for
assessment purpose only.

SEE MAP 5S 10

North

Application No. 68197
Permit No. 48952

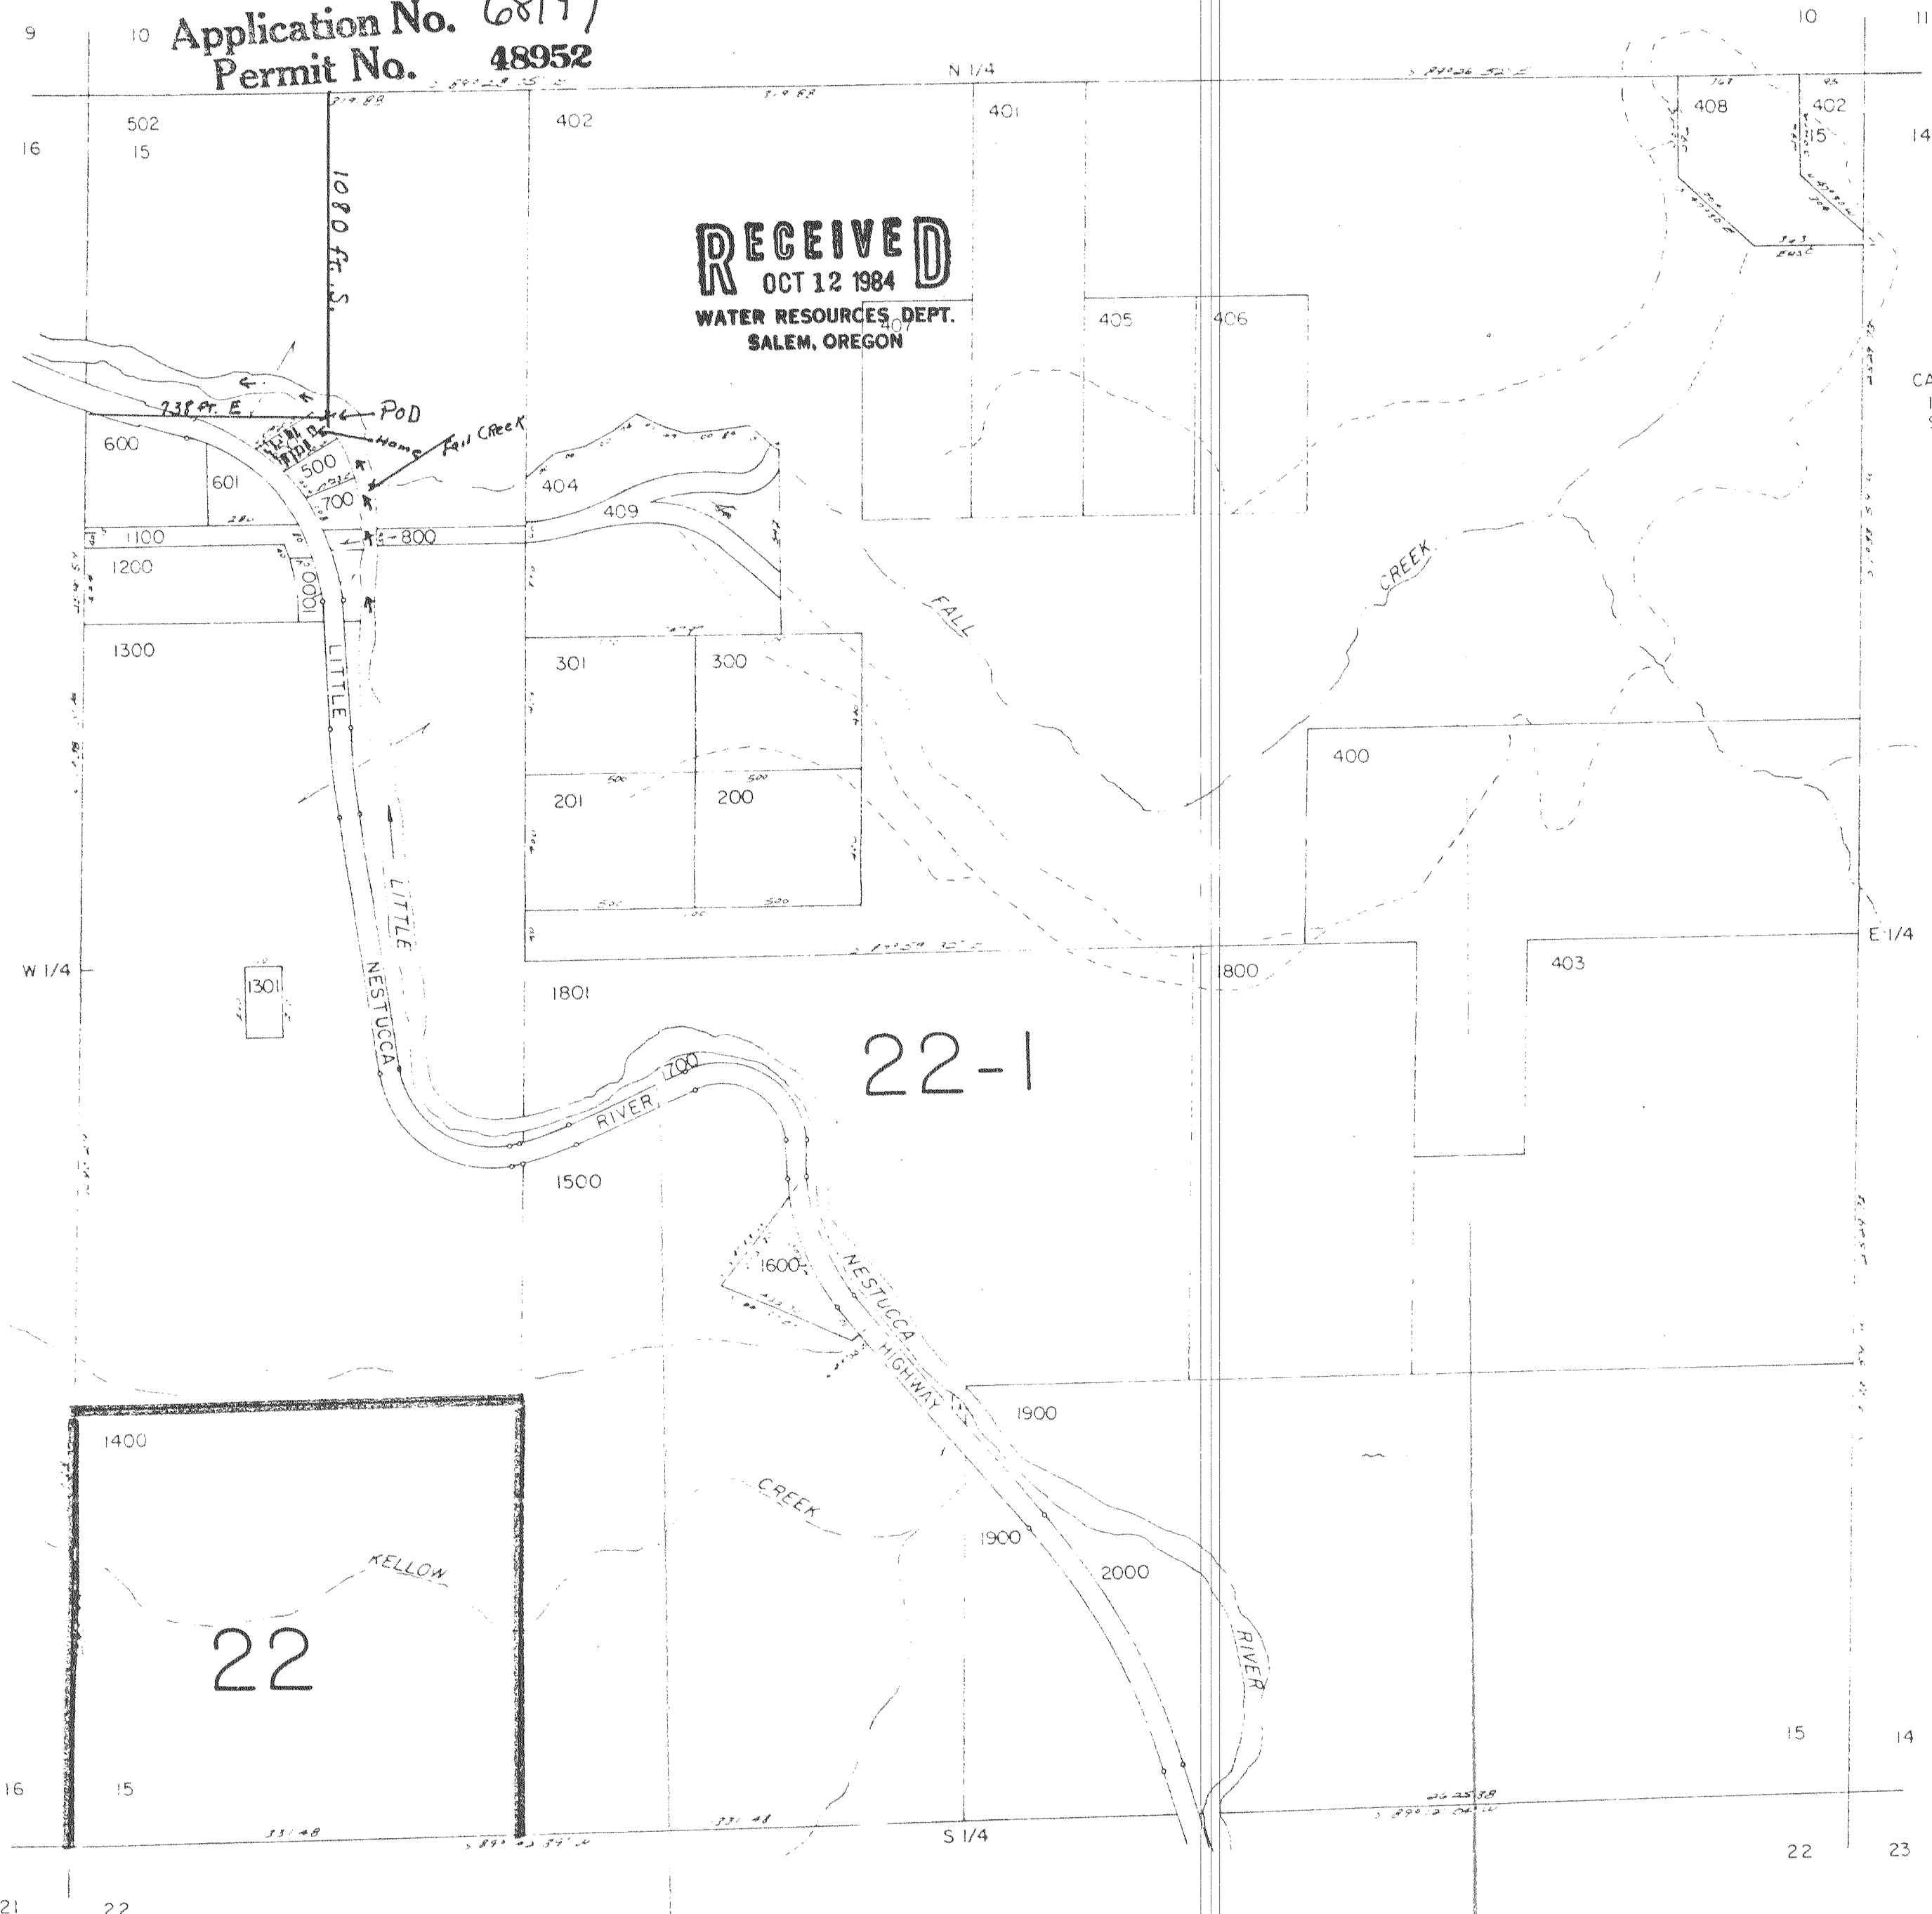

SEE MAP 5S 10 16

SEE MAP 5S 10

SEE MAP 5S 10

5S 10 15