


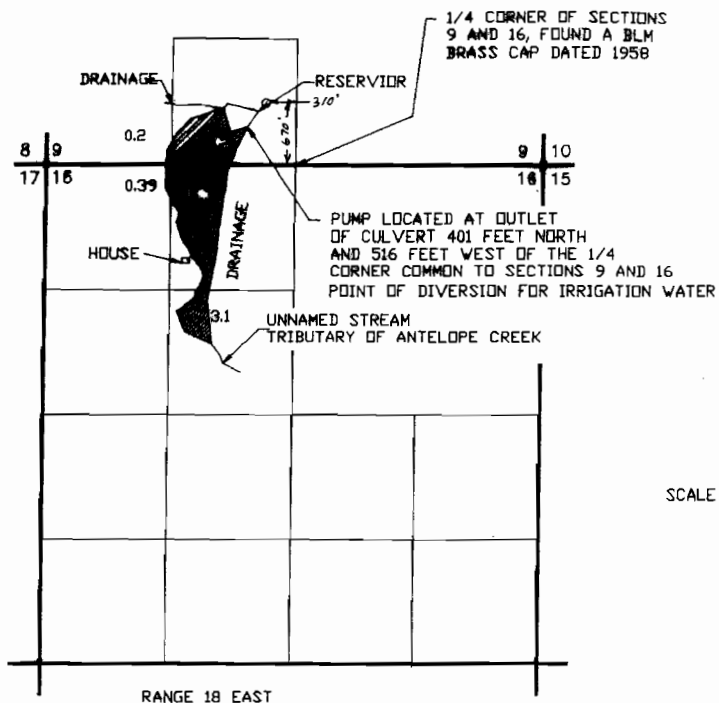

SITE REPORT

RESERVOIR (PERMIT # R10906) CAPACITY IS 12.7 ACRE FEET. PLEASE REFER TO AS BUILT PLANS AND INSPECTION LETTER SENT TO THE DAM SAFETY DIVISION FROM ANDERSON ENGINEERING AND SURVEYING, DATED APRIL 13, 1988

PLEASE REFER TO THESE PLANS FOR OUTLET CONDUIT LOCATION AND SPILLWAY INFORMATION

AREA IRRIGATED AS SHOWN HAD BEEN IRRIGATED WITH A SPRINKLER SYSTEM WITH WATER FROM THE RESERVOIR. WATER HAD BEEN PUMPED FROM THE RESERVOIR INTO 3" DIAMETER SPRINKLER PIPE, THE PIPE WAS MOVED BY HAND TO COVER THE AREA SHOWN. APPROXIMATELY 10 SPRINKLERS WERE USED AT ONE TIME FOR A FLOW OF 75 GALLONS PER MINUTE. A 10 HORSE POWER PUMP WAS USED AND LOCATED AS SHOWN ON THE MAP. CROP AREA WAS PLANTED IN GRASS AND WELL MAINTAINED AT THE TIME OF INSPECTION. AREA HAD BEEN WELL IRRIGATED IN 1992 BUT DUE TO OWNERS HEALTH HAD NOT BEEN IRRIGATED IN 1993. PUMP LOCATION AND IRRIGATION LIMITS WERE SHOWN TO ME BY THE OWNER AT THE TIME OF INSPECTION. THE RESERVOIR WAS 2/3 FULL AT THE TIME OF INSPECTION AND THE IRRIGATED AREA HAD A GOOD STAND OF GRASS, IT WAS EVIDENT THAT BENEFICIAL USE OF THE WATER HAD BEEN MADE.

TOTAL AREA IRRIGATED UNDER PERMIT 50260 28.19 ACRES

THE FINAL PROOF SURVEY AND INSPECTION OF THE USE AS FOUND TO BE COMPLETED UNDER THE TERMS AND CONDITIONS OF PERMITS R-10906 AND 50260 WAS COMPLETED BY ME ON JULY 28, 1993 AND THE FACTS CONTAINED IN THIS REPORT AND ABOVE FINAL PROOF MAP ARE CORRECT TO THE BEST OF MY KNOWLEDGE.

Darryl J. Anderson
DARRYL J. ANDERSON
CERTIFIED WATER RIGHTS EXAMINER

I, PAUL PIANTANIDA AND EDNA PIANTANIDA, AGREE TO THE FINDINGS OF THE WATER RIGHTS EXAMINER AND DO SUBMIT THIS SITE REPORT AND MAP AS MY CLAIM OF BENEFICIAL USE OF THE WATER AS PROVIDED UNDER THE TERMS AND CONDITIONS OF PERMITS R-10906 AND 50260.

Paul Piantanida
PAUL PIANTANIDA

Edna Piantanida
EDNA PIANTANIDA

DATE *Sept. 9, 1993*

RECEIVED

SEP 10 1993

WATER RESOURCES DEPT
SALEM, OREGON

ADDED RESERVOIR DIVISION 1/27/08 LHN

REVISIONS	BY
129/08	W.R.D. LHN



FINAL PROOF SURVEY AND SITE REPORT
FOR PERMITS R-10906 AND 50260

PAUL AND EDNA PIANTANIDA

HC 60 BOX 1978 97630
LAKEVIEW, OREGON (503) 947-2665

DATE: SEPT. 8, 1993

SCALE: SHOWN

DWG. BY: DJA

JOB # 93053

SHEET

1

OF 1 SHEETS