


2720 SPECIAL USES
WATER TRANSMISSION
CHRISTNER, ROBERT G.
LOT 9, TRACT X
ODELL LAKE


Application No: 64060
Permit No. 47158

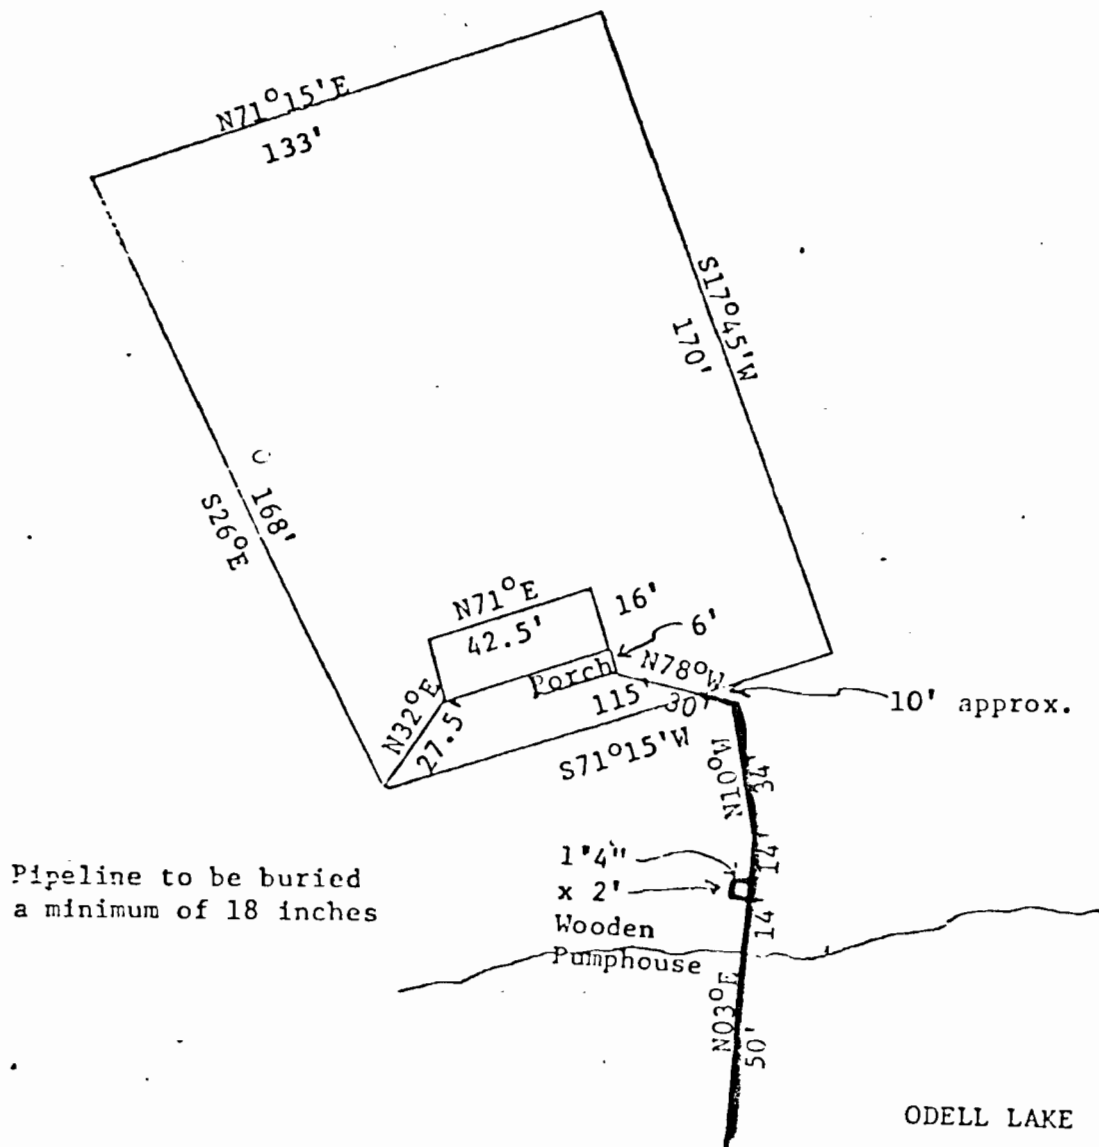

SCALE: 1" = 50'
SGE 9/8/76

RECEIVED
SEP 2 1982
WATER RESOURCES DEPT.
SALEM, OREGON

~~Application No.~~ ~~Permit No.~~ 64060
~~Application No.~~ ~~Permit No.~~ 47158
T.23S.R.6E.W.M.
(UNSURVEYED)

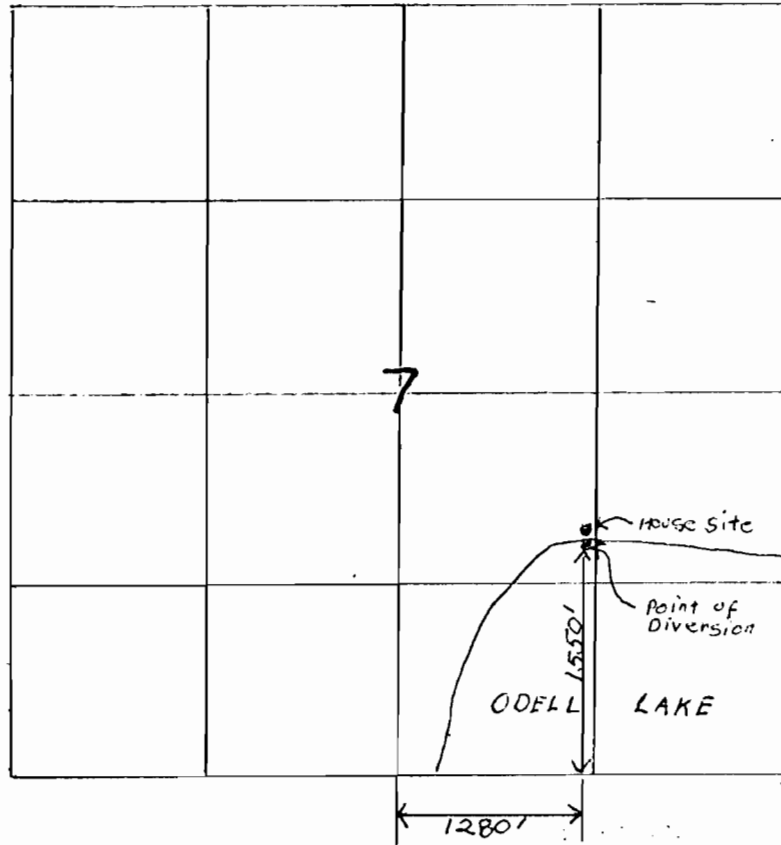

Scale 4" = 1 mile


RECEIVED

SEP 2 1982

WATER RESOURCES DEPT.
SALEM, OREGON

Tract X

Application No. 64060
Permit No. 47158

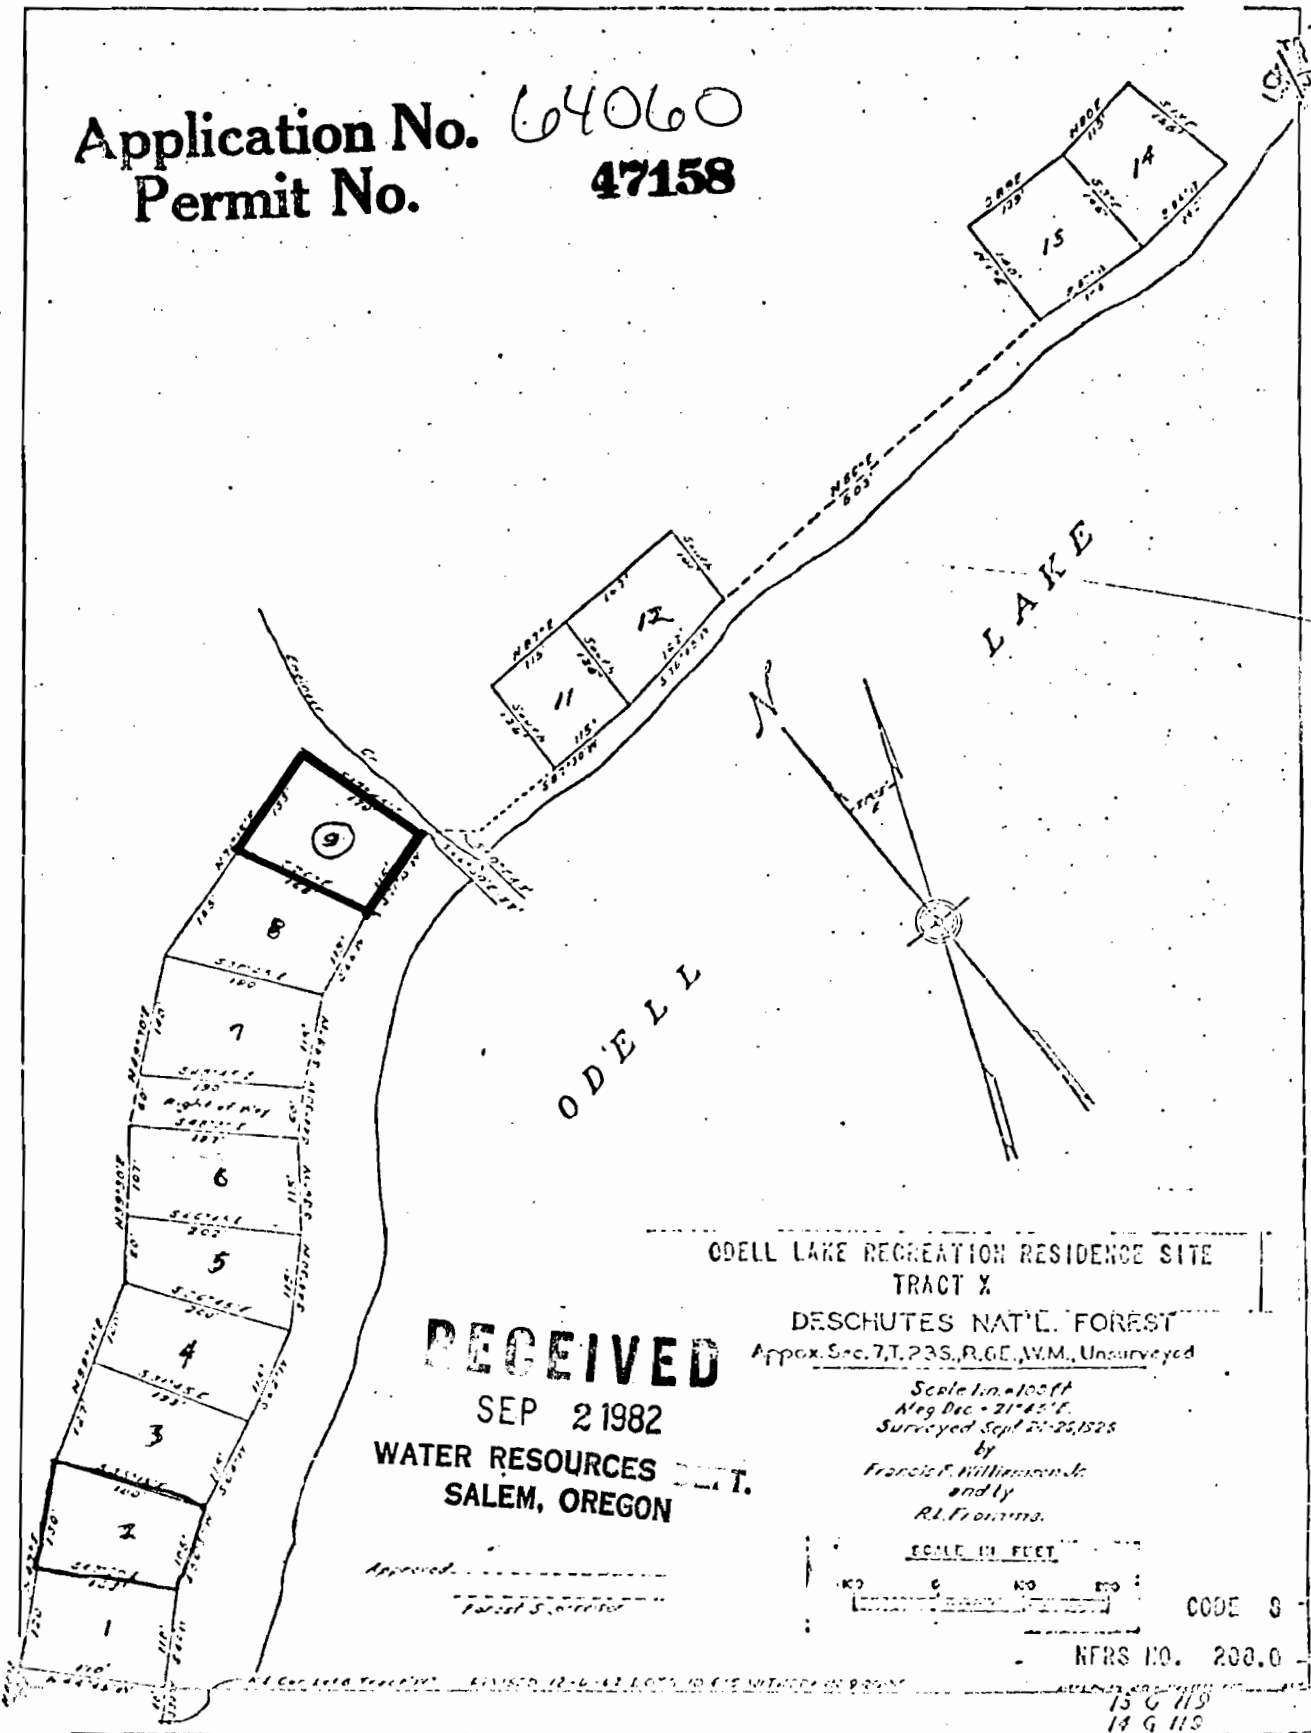

ODELL LAKE RECREATION RESIDENCE SITE
TRACT X

DESCHUTES NAT'L. FOREST

Approx. Sec. 7, T. 23 S., R. 6 E., W. M., Unsurveyed


RECEIVED

SEP 2 1982

WATER RESOURCES DEPT.
SALEM, OREGON

Scale 1 in. = 100 ft.
Mag. Dec. = 21° 45' E.
Surveyed Sept. 25, 1978
by
Francis F. Williamson, Jr.
and by
R. L. Fromms.

SCALE IN FEET

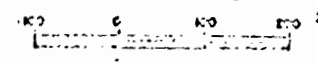

CODE 9

NFRS NO. 200.0

13 G. 119
14 G. 119

733