


FINAL PROOF SURVEY
 UNDER
 APPLICATION NO.R-71972 PERMIT NO.R-11518
 IN THE NAME OF
 NICKIE A CARTER, SR.
 NE 1/4 OF THE NE 1/4
 OF SECTION 27
 T.11S., R.1W., W.M.
 LINN COUNTY, OREGON
 SCALE: 1"=400'-0"

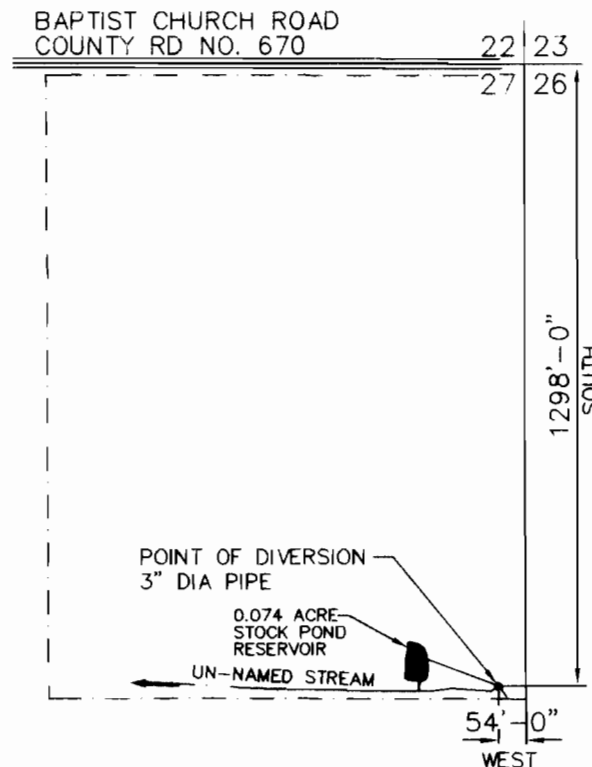

RECEIVED

OCT 31 1996

NORTHWEST CORNER
 SALEM OREGON

LEGEND:

- SECTION LINE
- FORTY LINE
- - - - - PROPERTY LINE
- UN-NAMED STREAM
- TRIBUTARY OF BEAVER CREEK

J. Edward Henricks

I J. EDWARD HENRICKS, BEING DULY SWORN AS A WATER RIGHT EXAMINER LICENSE NO. 170 HAVE PREPARED THIS MAP FOR NICKIE A. CARTER, SR. ON THIS 14th DAY OF SEPTEMBER 1996. THE AREA HATCHED REPRESENTS THE EXISTING POND FOR STOCK WATERING.

PREPARATION OF THIS MAP IS FOR THE PURPOSE OF IDENTIFYING THE LOCATION OF THE WATER RIGHT ONLY AND HAS NO INTENT TO PROVIDE DIMENSIONS OR LOCATION OF PROPERTY OWNERSHIP LINES.

ONLY DOCUMENTS STAMPED
 WITH RED INK ARE ORIGINALS